

**Coal Combustion Residual
Surface Impoundment
History of Construction
Documentation**

**Basin Electric Power Cooperative
Laramie River Station**

October 2016

Table of Contents

Purpose and Introduction.....	3
Previous Studies.....	3
Operator Contact Information.....	4
Location of CCR Unit(s) on USGS map	4
Purpose and Use of CCR units	4
CCR Unit Watershed	4
Foundation and Abutment Materials	4
Engineering Properties of Construction Materials	5
Detailed Dimensional Drawings	6
Existing Instrumentation.....	6
Area-capacity Tables	6
Spillways and Diversion Features	6
Construction Specifications for Maintenance and Repair	6
Structural Stability Information	7
Recordkeeping and Reporting	7
Certification Statement.....	7
Appendix I.....	8
Appendix II.....	9
Appendix III.....	10

Purpose and Introduction

The purpose of this document is to demonstrate compliance with 40 CFR §257.73 (c) which requires the owner or operator to compile a history of construction for existing Coal Combustion Residual (CCR) surface impoundments. The history of construction shall contain, to the extent feasible, the information specified in paragraphs (c)(1)(i) through (xi) of 40 CFR 257.73.

Laramie River Station (LRS) is owned by Missouri Basin Power Project (MBPP) and operated by Basin Electric Power Cooperative (Basin Electric). LRS consists of three 570 megawatt (MW) units located approximately five miles northeast of Wheatland in Platte County, Wyoming. LRS address is 347 Grayrocks Road, Wheatland, WY 82201. Unit 1 went online in 1980, Unit 2 went online in 1981, and Unit 3 went online in 1982.

The Bottom Ash Pond complex is comprised of three cells (1, 2, and 3) and the Emergency Holding Pond complex is comprised of two cells (East and West). For the purposes of this report, the CCR surface impoundments at LRS will be referred to as Bottom Ash Pond 1, Bottom Ash Pond 2, Bottom Ash Pond 3, East Emergency Holding Pond and West Emergency Holding Pond.

The history of construction presented herein was compiled based on existing documentation, to the extent that it is reasonably and readily available and Basin Electric's site experience.

Previous Studies

The United States Environmental Protection Agency (EPA) commissioned an assessment of the five CCR surface impoundments at LRS in April 2011. The August 2012 EPA Report recommended that LRS address the geotechnical stability of the perimeter dikes that surround the CCR impoundments at the site.

Based on the recommendations provided in the EPA Report, Basin Electric commissioned AECOM to conduct a subsurface investigation and geotechnical engineering evaluation of the perimeter dikes for the CCR impoundments at LRS. The AECOM report described the subsurface conditions encountered in the soil borings completed at the site and included results of a laboratory testing program. Information regarding the engineering properties of foundation

and embankment materials presented in this document is largely derived from the aforementioned EPA and AECOM reports.

Operator Contact Information

LRS is owned by MBPP and operated by Basin Electric. MBPP consists of six electric utilities (Basin Electric, Heartland Consumers Power District, Lincoln Electric System, Tri-State Generation and Transmission Association, Western Minnesota Municipal Power Agency and Wyoming Municipal Power Agency). The address of the operator of the CCR impoundments (Basin Electric) is 1717 East Interstate Avenue, Bismarck, ND 58503.

Location of CCR Unit(s) on USGS map

The locations of the five LRS surface impoundments are identified on the map presented in Appendix I.

Purpose and Use of CCR units

Bottom ash and boiler slag from LRS are sluiced to Bottom Ash Pond 3. Water from Bottom Ash Pond 3 is decanted into Bottom Ash Ponds 1 and 2 and then recirculated for various plant processes. Flue gas emission control residuals and water treatment plant spent lime slurry are sluiced into the West Emergency Holding Pond. Water from the West Emergency Pond is decanted into the East Emergency Pond.

CCR Unit Watershed

The general area around LRS consists of a physiographic feature called the Wheatland Flats that covers approximately 125 square miles. The Wheatland Flats are made up of seven distinct river terraces that rise 25 to 160 feet above the present stream levels of the Laramie River. The entire LRS plant site is constructed on the fourth and fifth river terraces. As such, the CCR surface impoundments are located within the Laramie River watershed.

Foundation and Abutment Materials

Surface geology in the vicinity of LRS consists of Quaternary-age alluvial terrace sand, colluvium and loess deposits, underlain by the Arikaree Formation (lower Miocene/Oligocene). The colluvium and loess deposits typically consist of fine grained sands, silty sands and silts

with intermittent deposits of clay and gravel with thicknesses reportedly ranging from about 0 to 50 feet. Colluvial soils are typically identified as loose, unconsolidated deposits of silt, sand and gravel that have accumulated at the base of hill slopes and ridges through erosional processes (rainwash, downward creep, etc.) Loess deposits are formed by the accumulation of wind-blown dusts and are composed of predominantly silt sized particles. The Arikaree Formation typically consists of light gray to tan, fine grained, poorly bedded sandstone containing numerous magnetite grains, with some lenses of siltstone, limestone and tuff.

Engineering Properties of Construction Materials

Bottom Ash Ponds 1, 2 and 3 were constructed with a 30 mil polyvinyl chloride (PVC) liner placed over six inches of bedding material covering the base of the ponds. The PVC liner on the interior slopes of the Bottom Ash Ponds 2 and 3 is overlain by 12 inches of soil and 12 inches of rip rap, serving as protection against wave and ice damage. Bottom Ash Pond 1 has a slightly different configuration, with the PVC liner overlain by 12 inches of soil, 6 inches of bentonite, 24 inches of soil and concrete slope protection at the surface. The East and West Emergency Holding Ponds have a 30 mil Hypalon liner protected by 12 inches of gravel filter and 12 inches of rip rap. The five CCR impoundments were constructed circa 1980, during the construction of LRS, and have not been expanded since being constructed. The impoundment dikes appear to have been constructed by excavating the impoundment basins and placing the excavated material along the perimeter of the basins to form the impoundment dikes.

The CCR unit dikes are generally comprised of granular fill soils at the near surface. The granular fill typically consists of fine to medium-grained sand (SP, SM, SC, etc.) and silt (ML) with minor amounts of gravel, clay and carbonates. A thin layer of silty clay (CL) fill was encountered from 4 to 6 feet in one soil boring. The fill thickness below the crest of the dikes was found to range from about 6 to 28 feet. Fill thickness ranged from about 0 to 8 feet at the toe of the dikes. Fill soils were not encountered at the toe of the dike in two of 23 soil borings completed by AECOM.

The relative density of the granular fill soils was typically in the medium dense to very dense range with some intermittent deposits of loose material, based on Standard Penetration Test (SPT) results. Elevated SPT N-values were observed at several locations, possibly due to local cobble or boulder size material within the granular impoundment fill. Bottom ash, slag, lime and other byproducts were not encountered within the soil borings. The impoundment dike fill soils

were similar in texture to the underlying native geologic deposits (described above), supporting the notion that the impoundment dikes were constructed using locally derived material. It does not appear that bottom ash, slag, or lime byproducts were used as fill in dike construction.

Detailed Dimensional Drawings

Drawings Y46, Y164, Y165, Y172, and Y640 show construction details for the LRS surface impoundments. These drawings are included in Appendix II. Based on the review of the drawings listed above, no natural or manmade features that could adversely affect operation of these CCR units due to malfunction or mis-operation were identified.

Existing Instrumentation

Instrumentation at the five LRS surface impoundments includes only staff gauges to measure pool elevation in each of the ponds. No other instrumentation is present.

Area-capacity Tables

Drawings 0CY-6004 and 0CY-6005 include area-capacity tables for the LRS CCR surface impoundments. These drawings are included in Appendix III.

Spillways and Diversion Features

LRS is a zero discharge facility. No spillways are present. The CCR Units are all above grade; as such, diversion structures are not used. In 2016, the storage capacity of the impoundments was evaluated for a 24-hour duration design storm for the 1,000-year Inflow Design Flood (IDF) using an AutoCAD Civil3D computer model. The computer model evaluated the ability of the ponds to collect and control the 1,000-yr IDF under existing operational and maintenance procedures. The Civil3D model results for the impoundments indicate that the all CCR units have sufficient storage capacity to adequately manage inflows during peak discharge conditions created by the 1,000-yr IDF. Therefore, the spillway requirements in §257.73(d)(1)(v)(A) and (B) are not applicable to the impoundments at LRS.

Construction Specifications for Maintenance and Repair

Construction specifications for any maintenance or repair of the CCR units would be developed if and when necessary. Construction would be in accordance with applicable rules and

regulatory guidance, and would include appropriate use of ASTM Standards and industry best practices.

Structural Stability Information

There have been no signs of structural instability for any of the five Ponds at LRS. The April 2014 AECOM Report, however, found a marginal factor of safety (due to overly steep exterior slopes) for the south dikes on the East and West Emergency Holding Ponds. Basin Electric has taken actions to increase the factor of safety to a more conservative level, consistent with requirements set forth in the CCR Rule. Structural stability and safety factor assessment requirements for each of the CCR surface impoundments at LRS are addressed in standalone documents.


Recordkeeping and Reporting

A copy of this document will be placed into the facility's operating record in accordance with 40 CFR §257.105 (Recordkeeping Requirements) and will be posted to Basin Electric Power Cooperative's CCR Web site in accordance with 40 CFR §257.107 (Publicly accessible internet site requirements). Notification will be sent to the relevant State Director in accordance with 40 CFR §257.106 (Notification Requirements).


Certification Statement

In accordance with the requirements of 40 CFR §257.73 as specified in the *Standards of Coal Combustion Residuals in Landfills and Impoundments*, I certify the documentation regarding LRS CCR surface impoundment History of Construction is accurate.

Kevin L. Solie, WY PE-15120
October 17, 2016

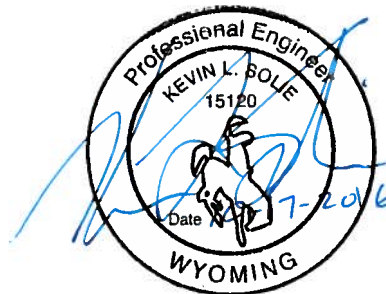


Appendix I

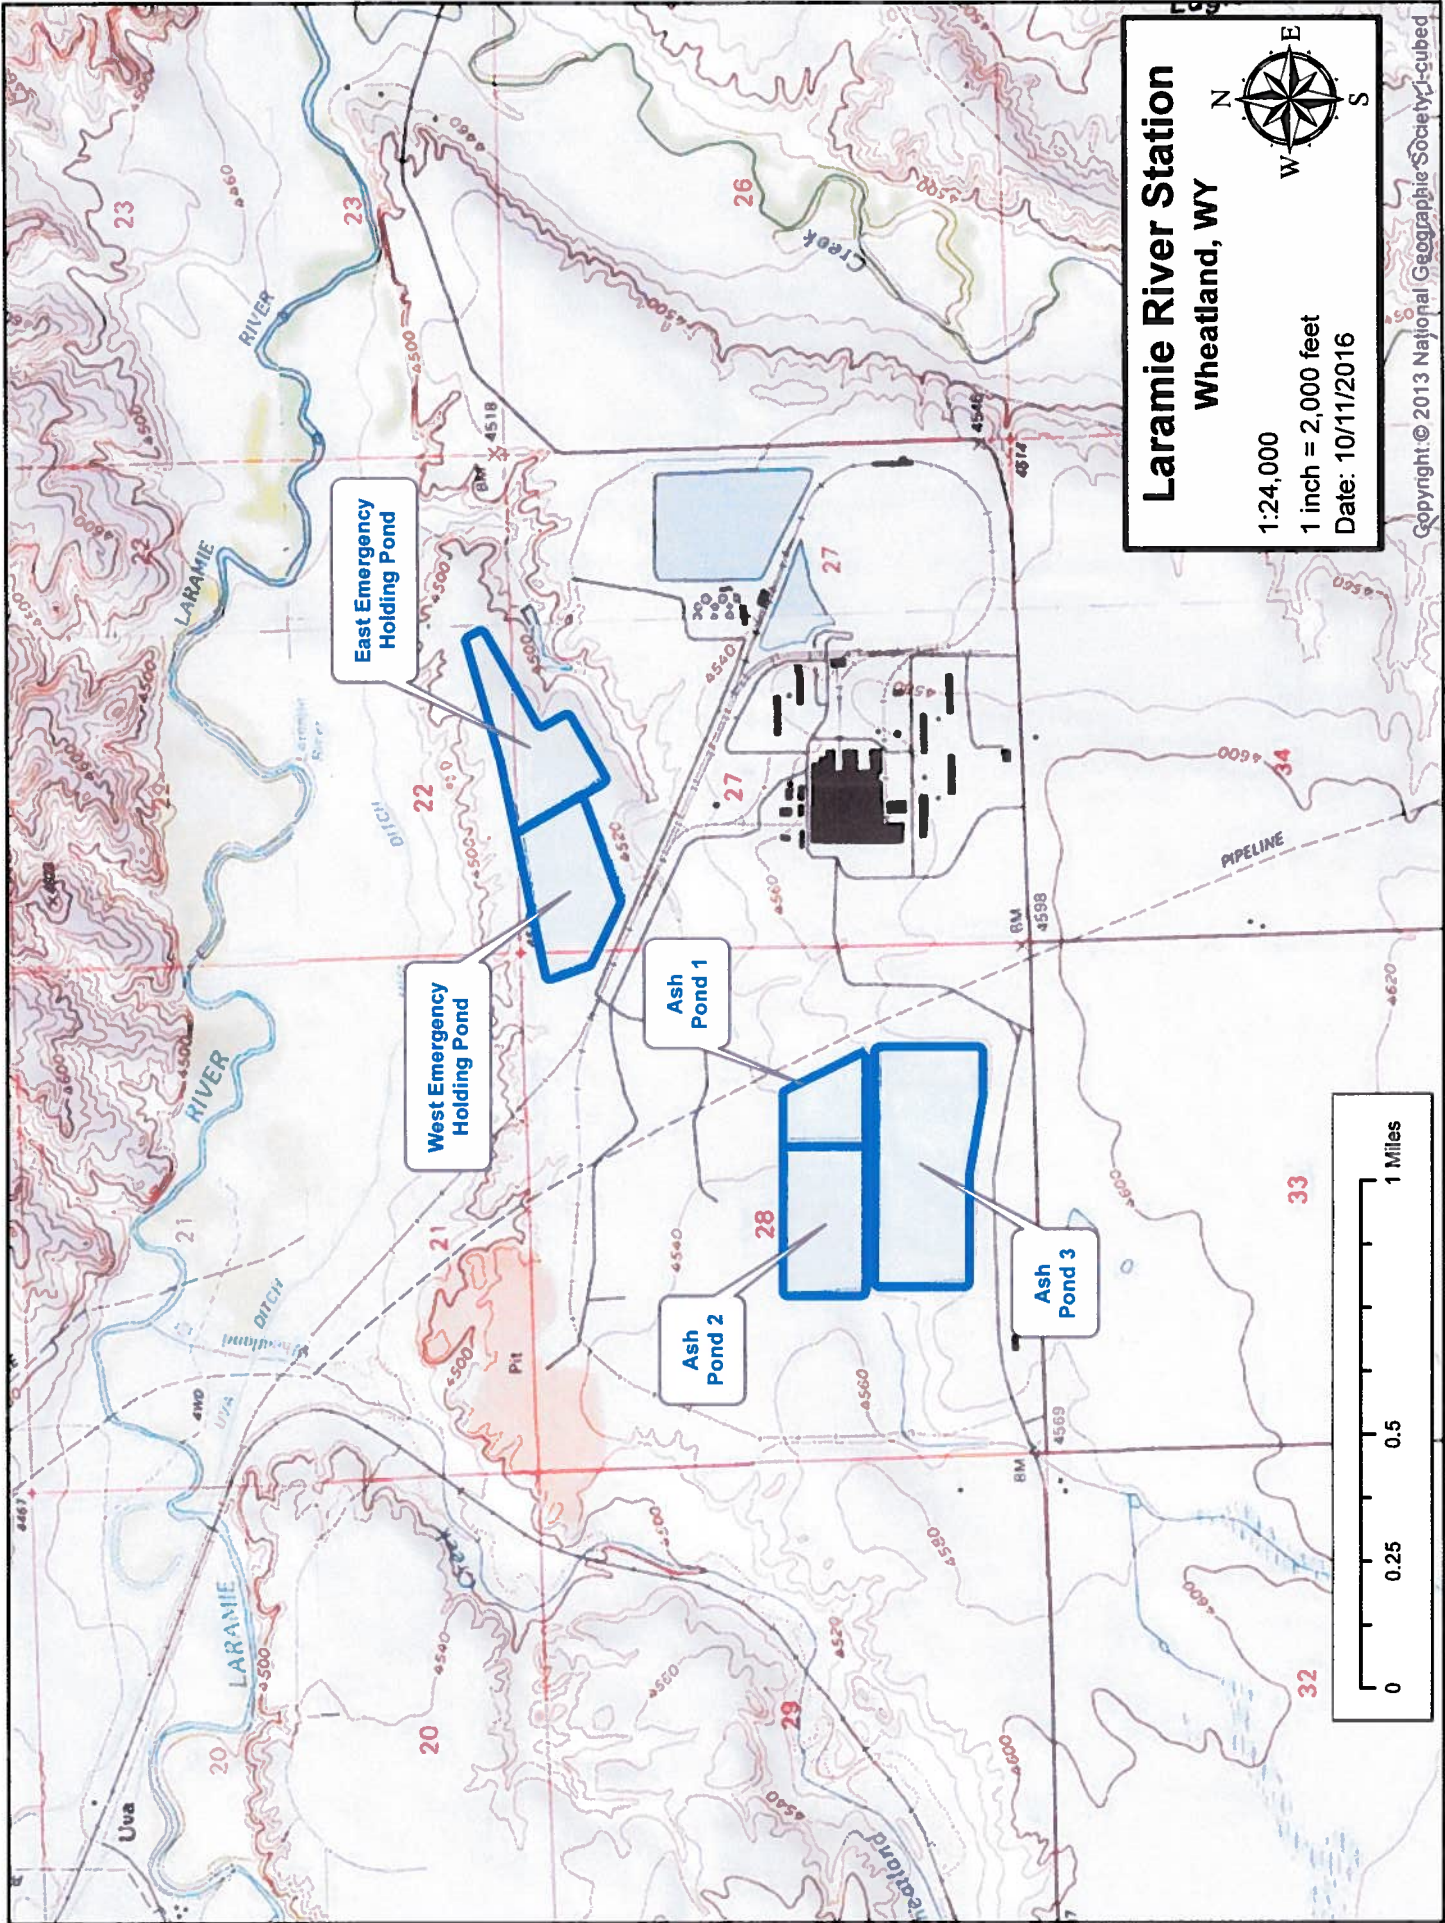


Laramie River Station
 Wheatland, WY

1:24,000
 1 inch = 2,000 feet
 Date: 10/11/2016

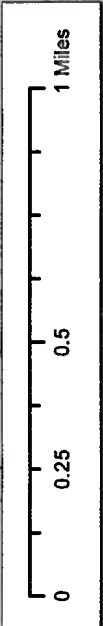

Appendix II

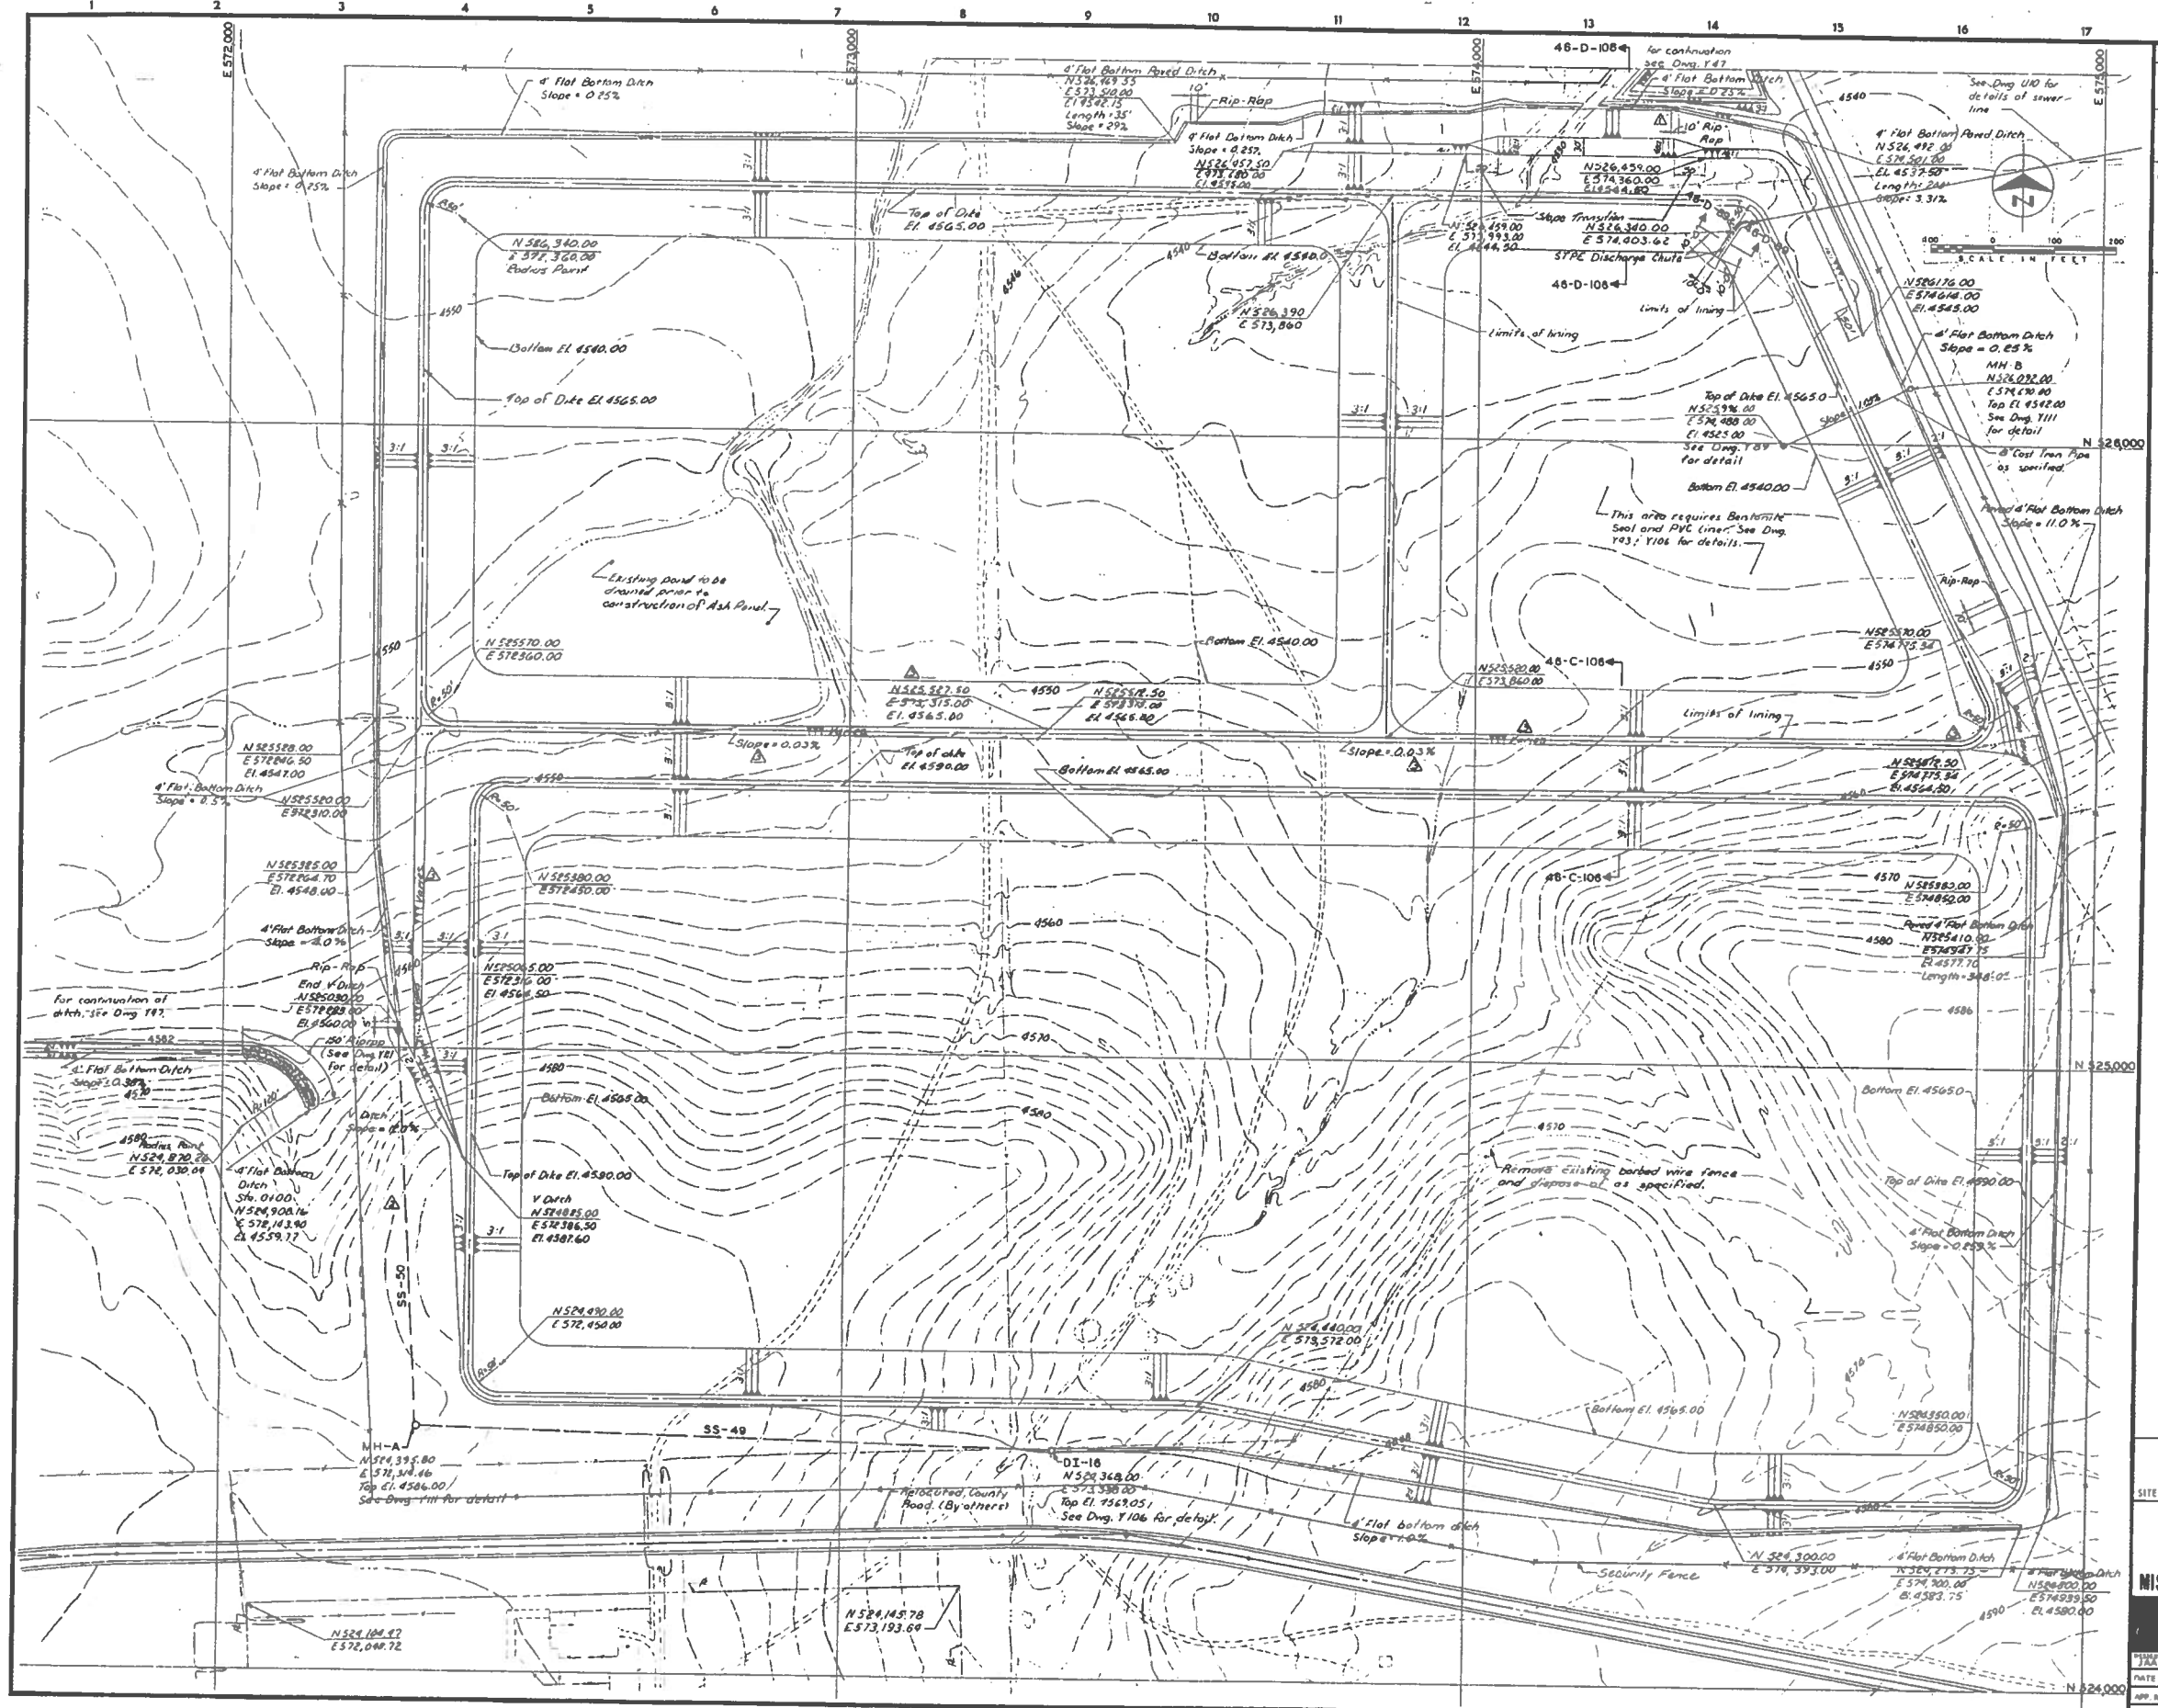

NO.	DATE	BY	REVISION
1	4-17-76	DLM	Revised as per Addendum No. 2.
2	6-16-76	JCH	Issued
3	7-24-76	RLS	Revised 33-50 as per Change Order No. 1.
4	7-26-76	JCH	Issued
5	3-17-77	DJB	Revised side slope from 4:1 to 3:1, indicated slope of ditch 0.03%. Added coordinate and spot elevation, offset in order to existing coordinate.
6	3-17-77	RAW	Issued
7	3-15-78	RAA	

CONFORMING TO CONSTRUCTION RECORDS

ASH POND GRADING PLAN
 CONTRACT NO. 3438
 SITE PREPARATION & CONSTRUCTION FACILITIES


LARAMIE RIVER STATION
 UNITS 1&2
 Wheeland, Wyoming
MISSOURI BASIN POWER PROJECT

Burns & McDonnell
 Engineers-Architects-Consultants
 FARMAS CITY, MISSOURI

DATE: March 12, 1976
 APP. BEA: March 12, 1976
 APP. PROJ. MGR:

DRAWING NO. Y46-4
 PROJECT: 74-013-1
 SHEET: 04 OF 04

Y46

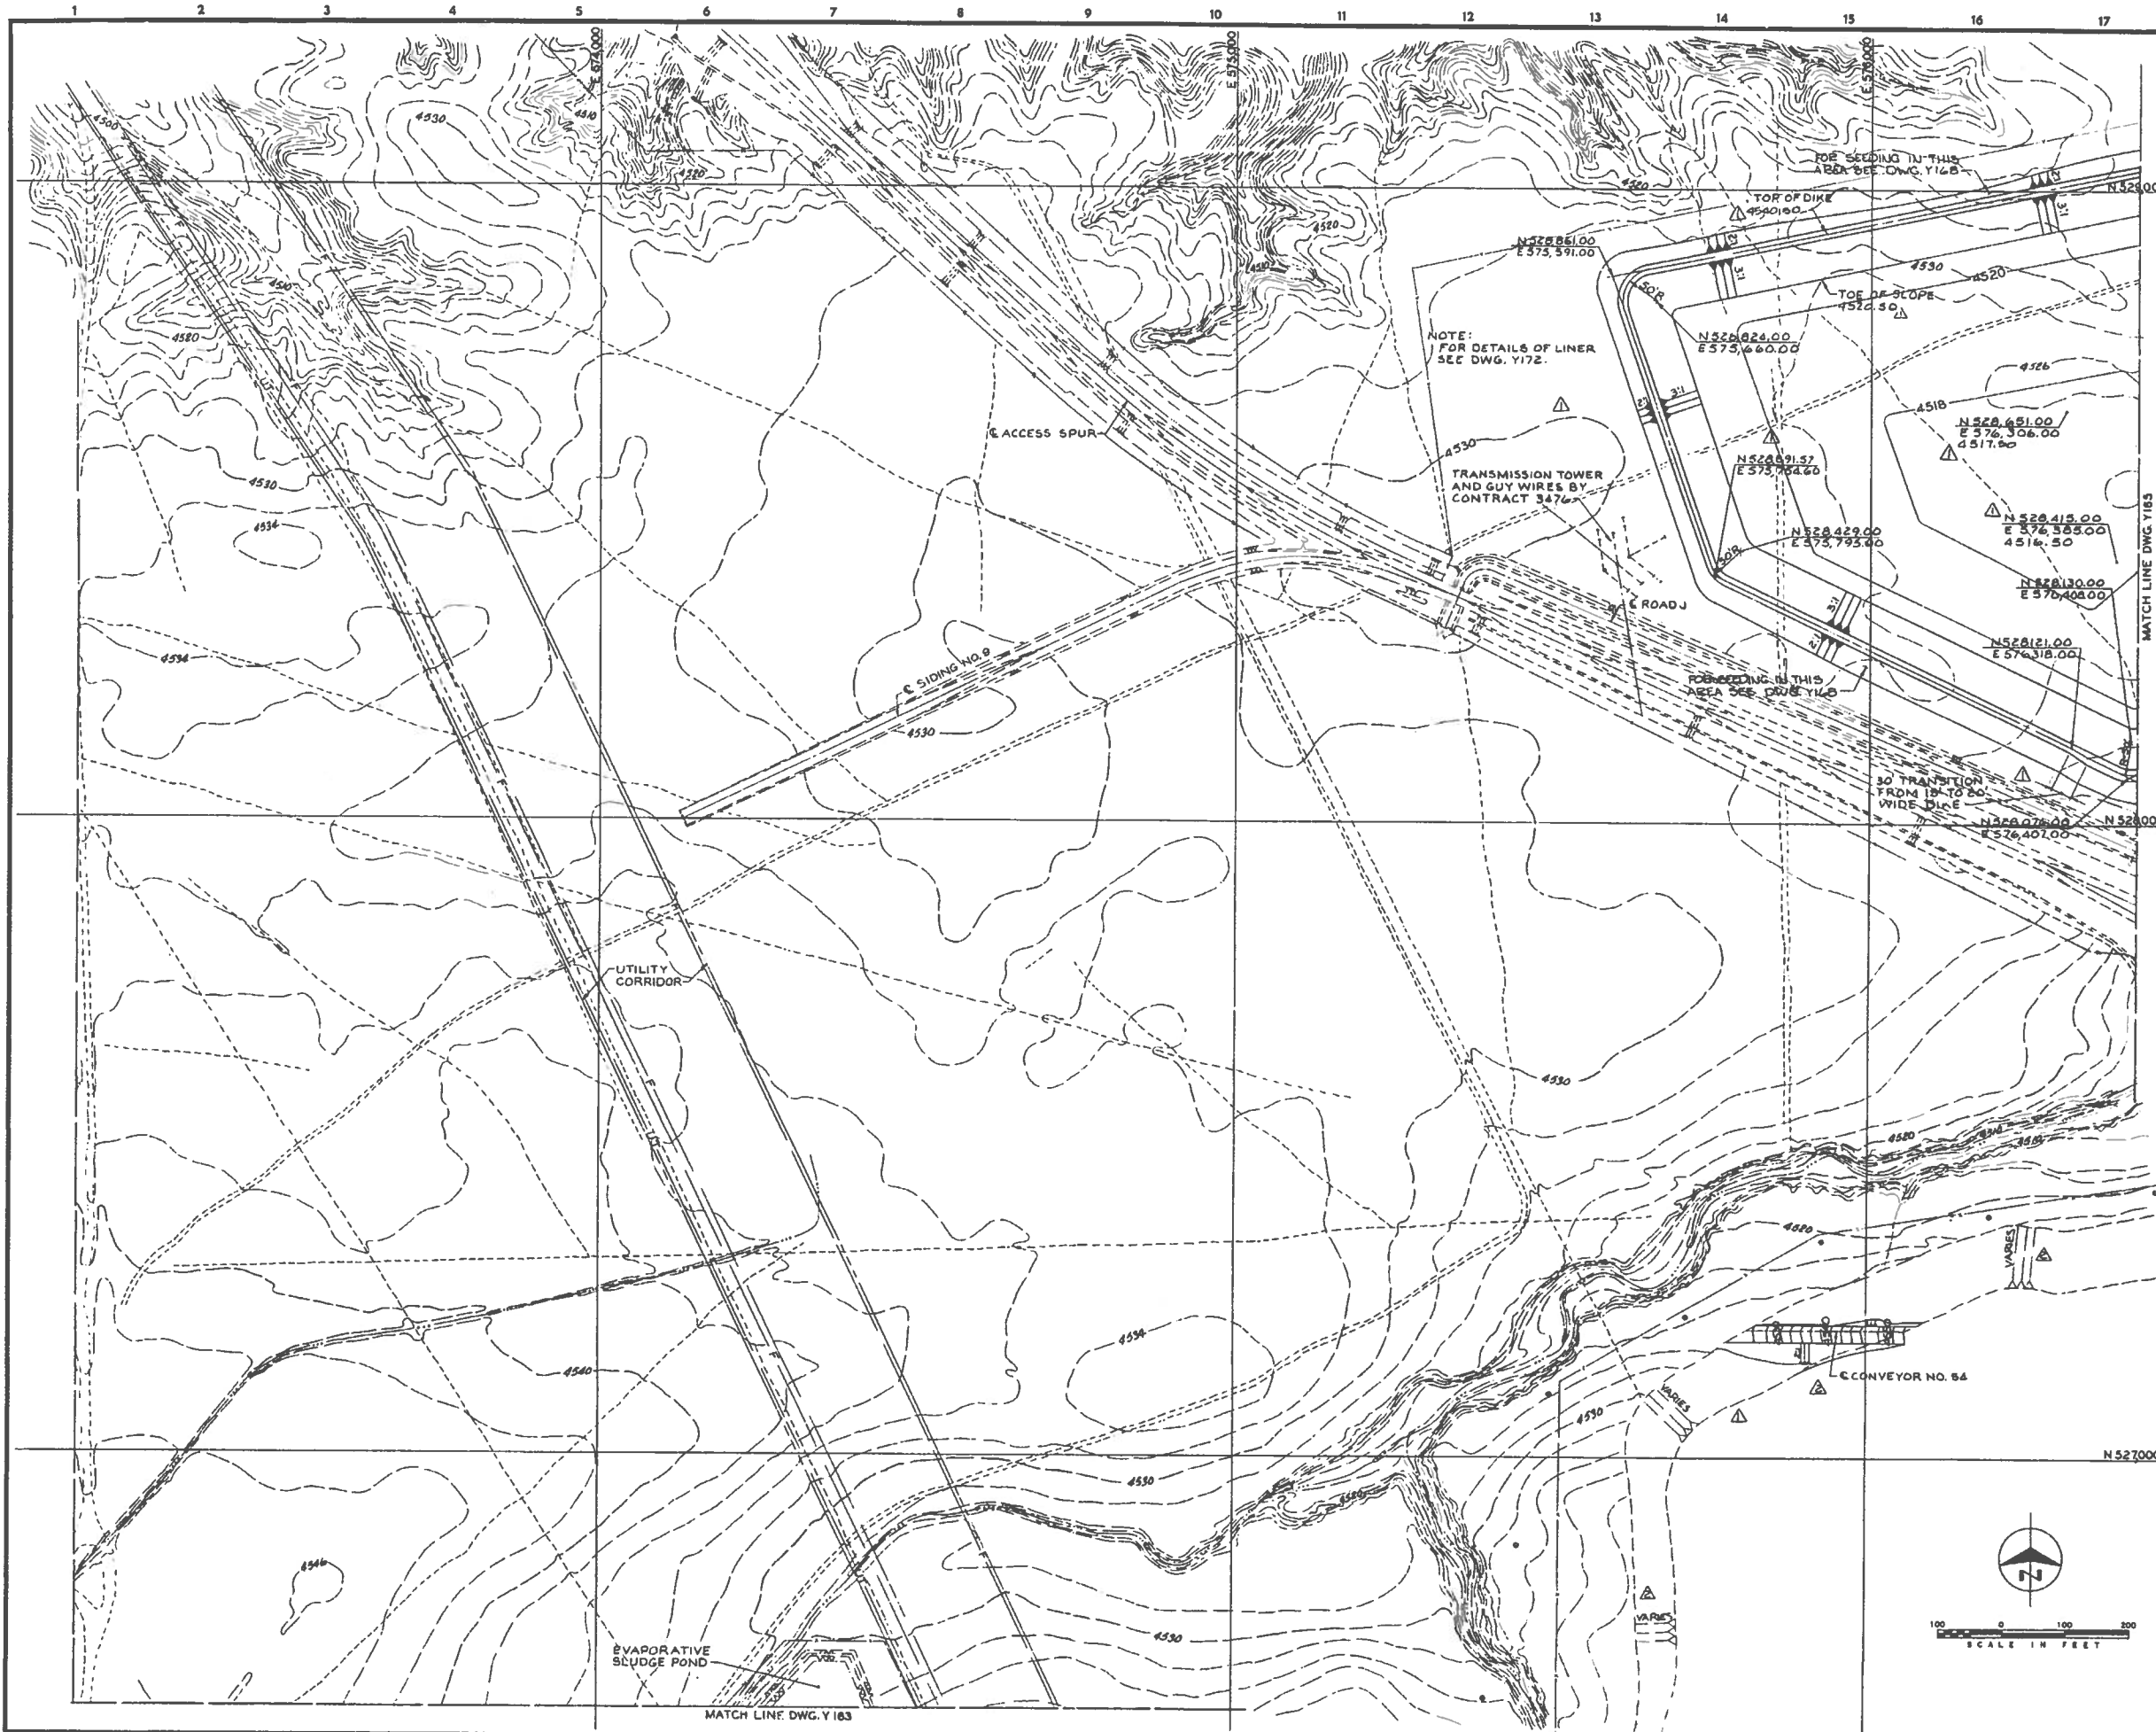

NO	DATE	BY	REVISION
320/76		DEH	ISSUED FOR CONSTRUCTION
3/3/76		DJB	CHANGED 30' TRANSITION FROM INSIDE TO OUTSIDE OF DIKE.
4/2/76		DJB	REVISED ELEVATIONS AND UPDATED EXISTING GRADING.
4/14/76		DJB	REVISED DIKE AND ADDED TRANS-MISSION TOWER
7/10/76		DAY	LOWERED TOP OF DIKE INSIDE TOP OF SLOPE AND ALL SPOT ELEVATIONS 0.75'
5/17/76		DJB	ADDED SPOT ELEVATION N 528, 415.00 E 576, 385.00 AS PER CHANGE ORDER NO. 5001.
5/19/76		DEH	ISSUED
7/19/76		DJB	ADDED GRADING FOR CONVEYOR NO. 54 AND CORRECTED EXIST. GRADE.
7/21/76		DEH	ISSUED
7/22/76		FOBA	CONFORMING TO CONSTRUCTION RECORDS
1/12/78		DEH	ADDED NOTE 1

MATCH LINE DWG. Y163

NOTE:
FOR DETAILS OF LINER SEE DWG. Y172.

FOR SEEDING IN THIS AREA SEE DWG. Y16B

FOR SEEDING IN THIS AREA SEE DWG. Y16B

FOR SEEDING IN THIS AREA SEE DWG. Y16B

FOR SEEDING IN THIS AREA SEE DWG. Y16B

NOTES:
1. ELEVATIONS PROVIDED WITHIN BEST EMERGENCY HOLDING POND ARE TO HYPALON LINER


GRADING PLAN
EMERGENCY HOLDING POND - 1
CONTRACT NO. 3449
YARD STRUCTURES

LARAMIE RIVER STATION
UNITS 1&2
Wheatland, Wyoming


MISSOURI BASIN POWER PROJECT

Burns & McDonnell
Engineers - Architects - Consultants
KANSAS CITY, MISSOURI

DESIGNED	DETAILED	CHECKED	DRAWING NO.
RLS	DJB	RLS	Y164 - 4
DATE	DEC. 9 1977		REV.
APP. DEA		PROJECT	74-013-1
APP. PROJ. MGR.		SHEET	OF SHEETS

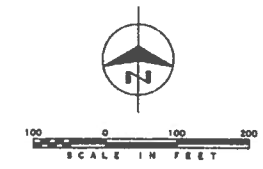

Y164

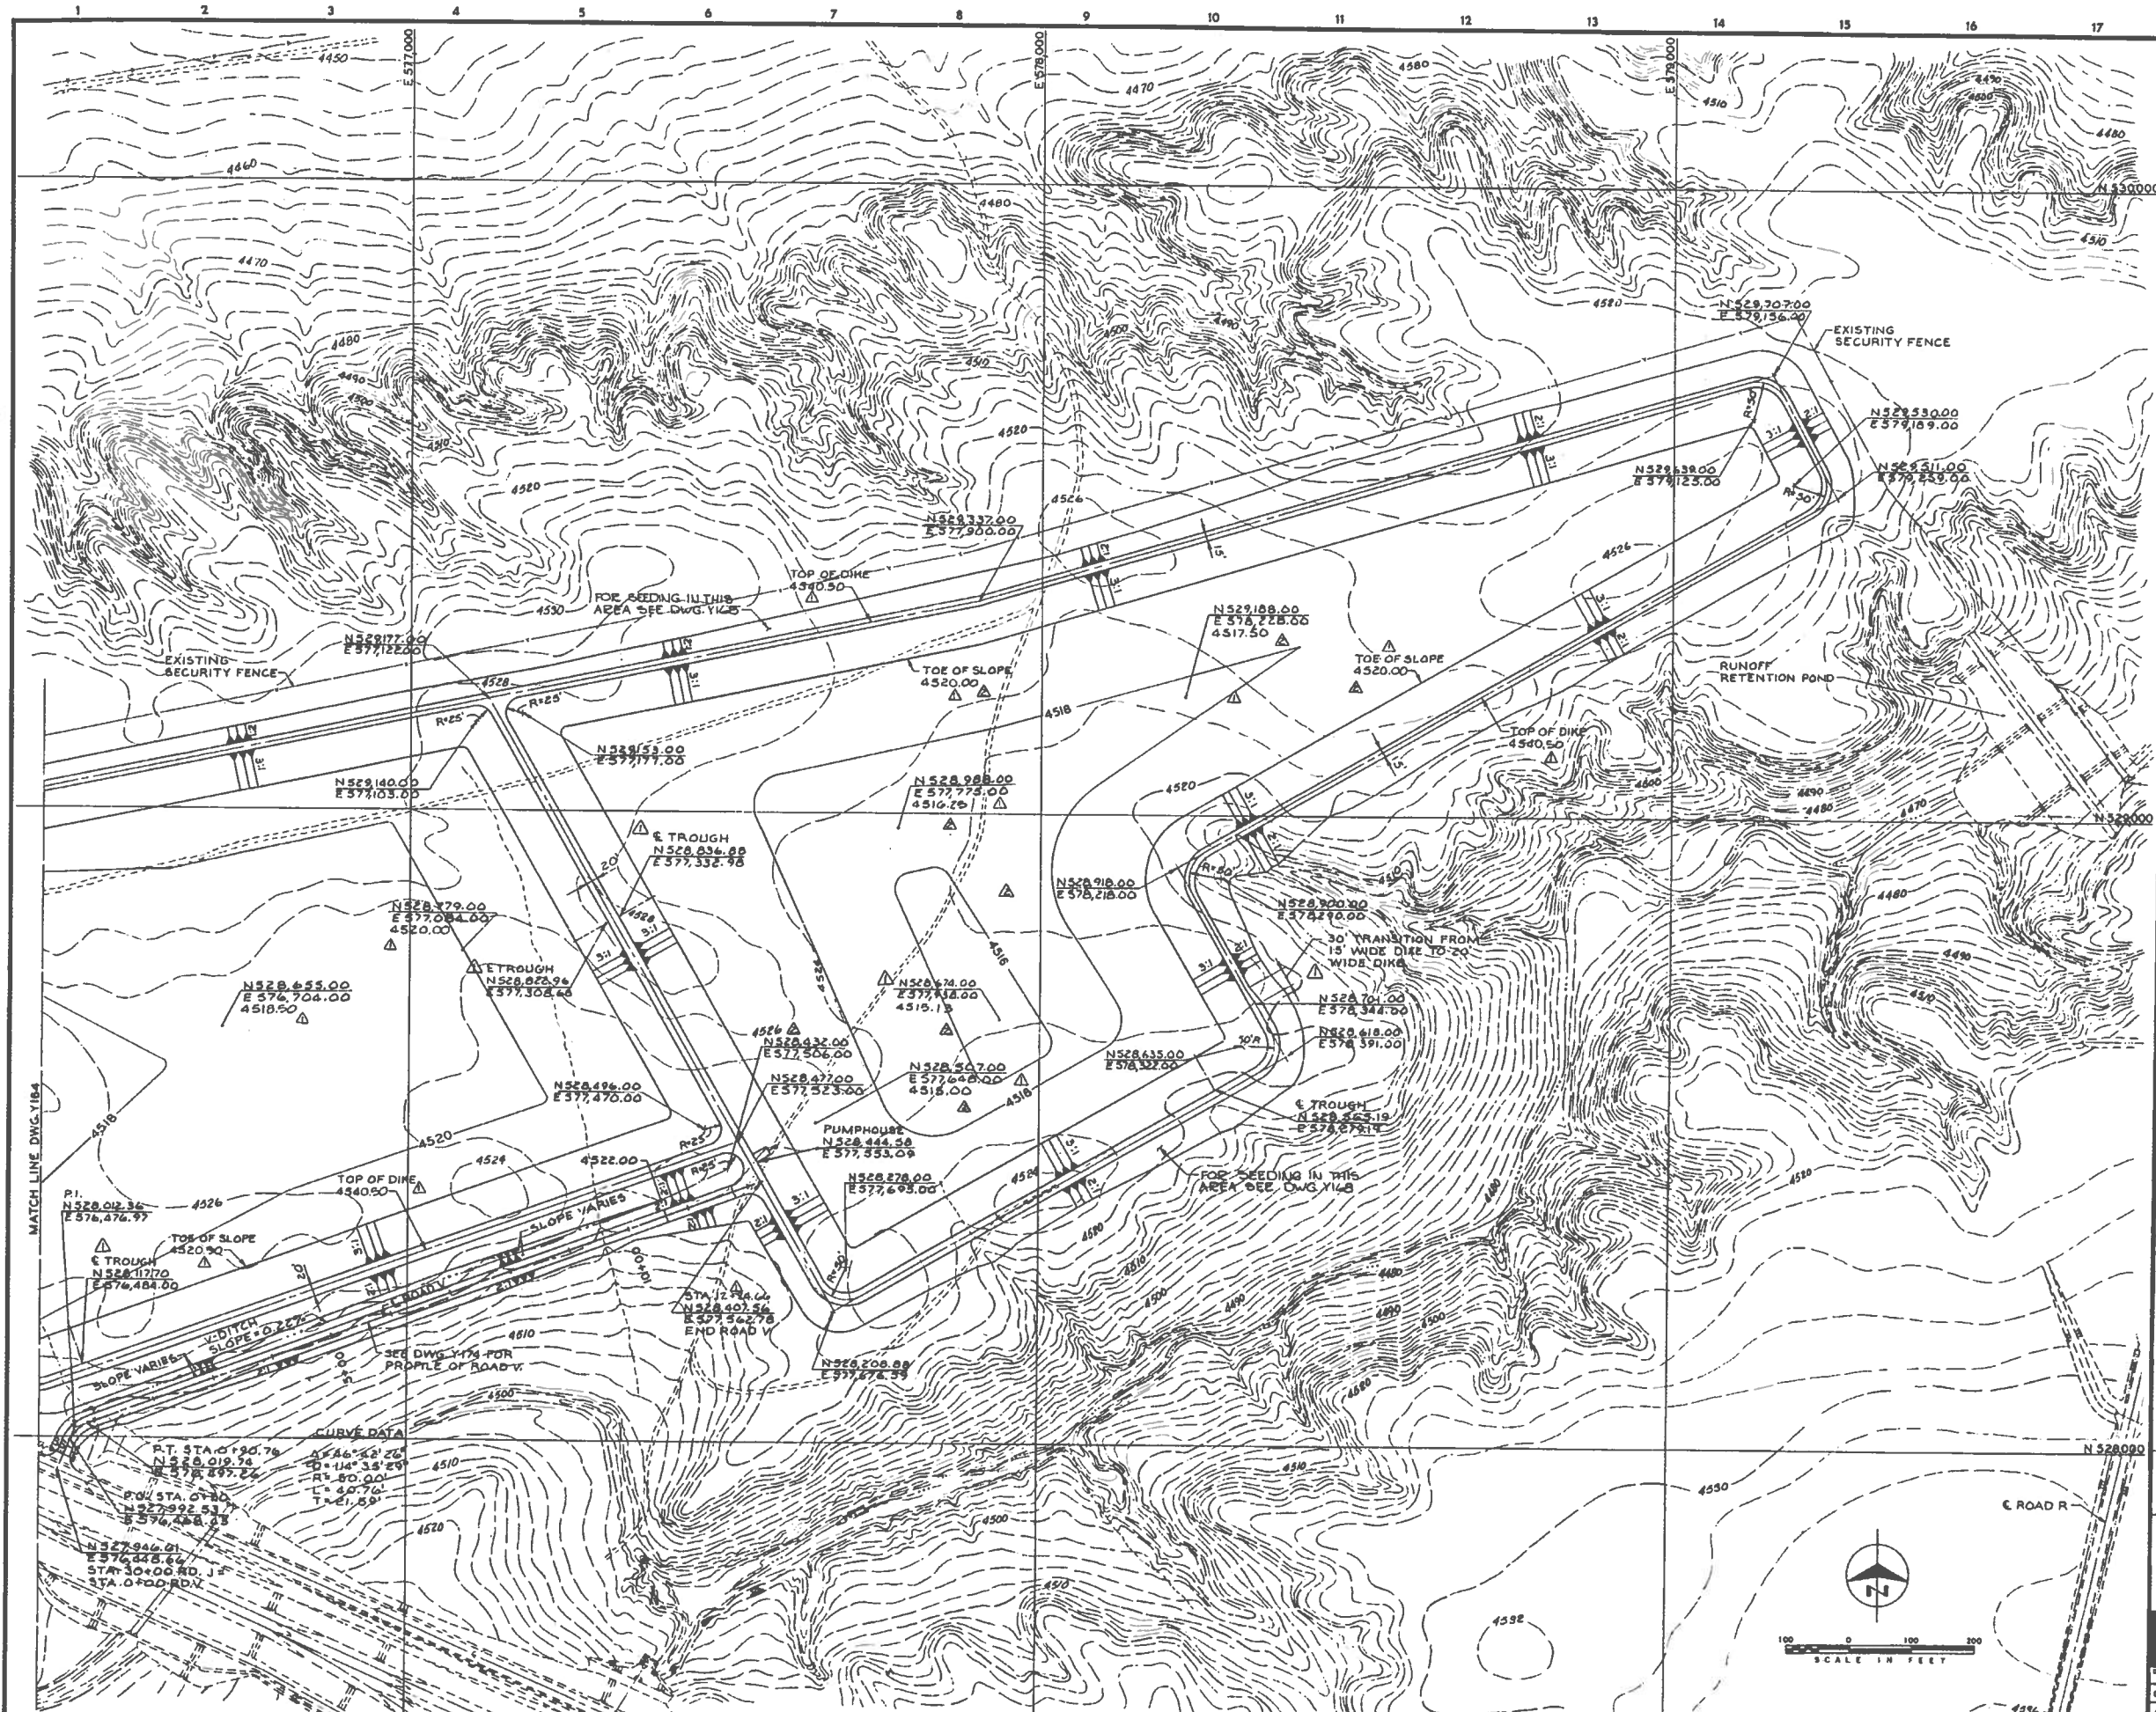

NO.	DATE	BY	REVISION
3/20/78		DEH	ISSUED FOR CONSTRUCTION
3/31/78		DJB	CHANGED 30' TRANSITION FROM INSIDE TO OUTSIDE OF DIKE
4/12/78		DJB	REVISED ELEVATIONS
5/01/78		DAY	LOWERED TOP OF DIKE, INSIDE TOE OF SLOPE, AND ALL SPOT ELEVATIONS 0.75'. CORRECTED END RD. V TO STA. 12+24.66. ADDED PUMPHOUSE, TROUGHS AND COORDINATES, AND NOTES 1, 2 & 3, AS PER CHANGE ORDER NO. 5001.
5/19/78		DEH	ISSUED
6/13/78		DJB	REVISED BOTTOM OF DIKE EL. IN EAST POND AS PER CHANGE ORDER NO. 3449-13
6/14/78		DJB	CORRECTED COORDINATE AT THE BEGINNING OF THE V-DITCH
		DEH	ISSUED
2/12/80		FOBA	CONFORMING TO CONSTRUCTION RECORDS
3/12/78		INT/DE	ADDED NOTE 4

- NOTES:
- FOR PIPING DETAILS SEE DWG. US8
 - FOR DETAILS OF PUMPHOUSE SEE DWG. A276 AND DWG. 5495
 - FOR DETAILS OF LINER INSTALL. SEE DWG. Y172
 - ELEVATIONS PROVIDED WITHIN WEST EMERGENCY HOLDING POND ARE TO HYDRA-LINER

GRADING PLAN
EMERGENCY HOLDING POND-2
CONTRACT NO. 3449
YARD STRUCTURES

LARAMIE RIVER STATION
UNITS 1&2
Wheatland, Wyoming
MISSOURI BASIN POWER PROJECT
Burns & McDonnell
Engineers - Architects - Consultants
KANSAS CITY, MISSOURI


DESIGNED BY DEH
CHECKED BY DJB
DATE DEC. 9, 1977

DRAWING NO.
Y185 - 4

APP. REA
APP. PROJ. MGR.


PROJECT 74-0121
SHEET OF SHEETS

Y185

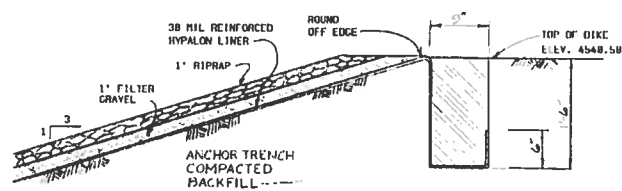

NOTES:
 1. THROW ALL DIRT FROM TRENCH EXCAVATION TOWARD CENTER OF DIKE AWAY FROM SLOPE.
 2. ANCHOR LINER AS SHOWN COMPLETELY AROUND BOTH CELLS OF THE POND.


TYPICAL LINER ANCHORING DETAIL
 NOT TO SCALE

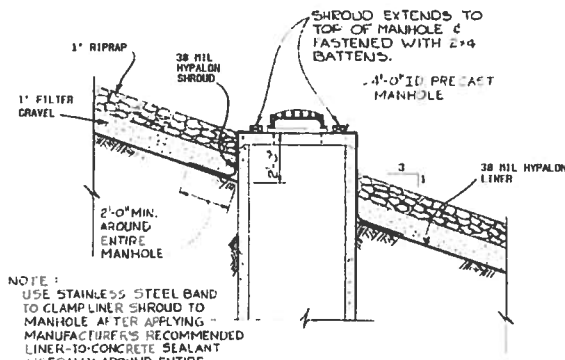


NOTE:
 USE STAINLESS STEEL BAND TO CLAMP LINER SHROUD TO MANHOLE AFTER APPLYING MANUFACTURER'S RECOMMENDED LINER-TO-CONCRETE SEALANT LIBERALLY AROUND ENTIRE AREA TO BE CLAMPED.

LINER ATTACHMENT DETAIL AT INLET STRUCTURE
 NOT TO SCALE


FOR DETAILS OF INLET STRUCTURE, SEE DWG. UP 56

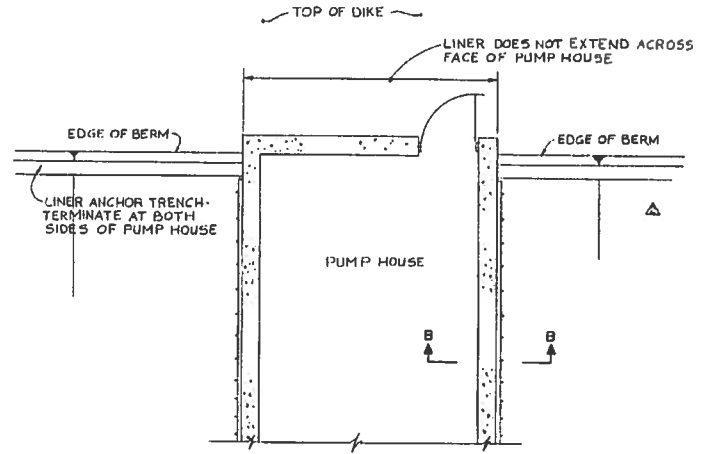

PLAN
 NOT TO SCALE
 FOR DETAILS OF PUMP HOUSE, SEE DWG. A 276

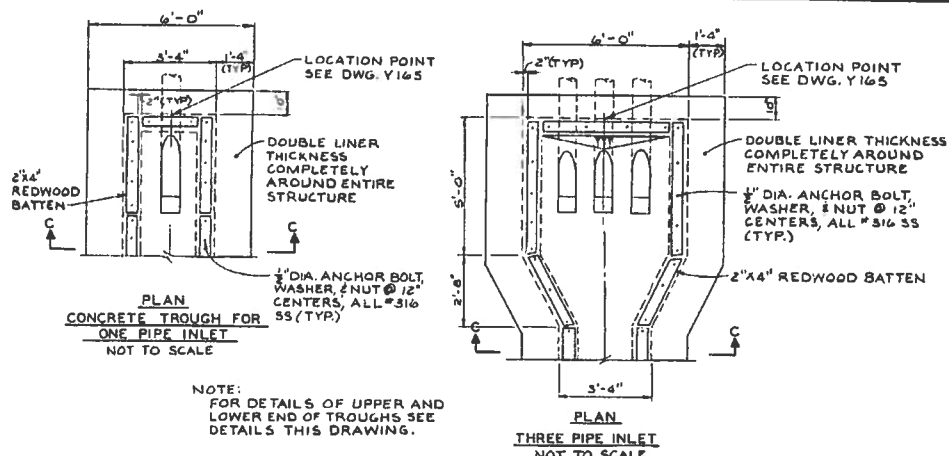


NOTE:
 FOR DETAILS OF UPPER AND LOWER END OF TROUGHS SEE DETAILS THIS DRAWING.

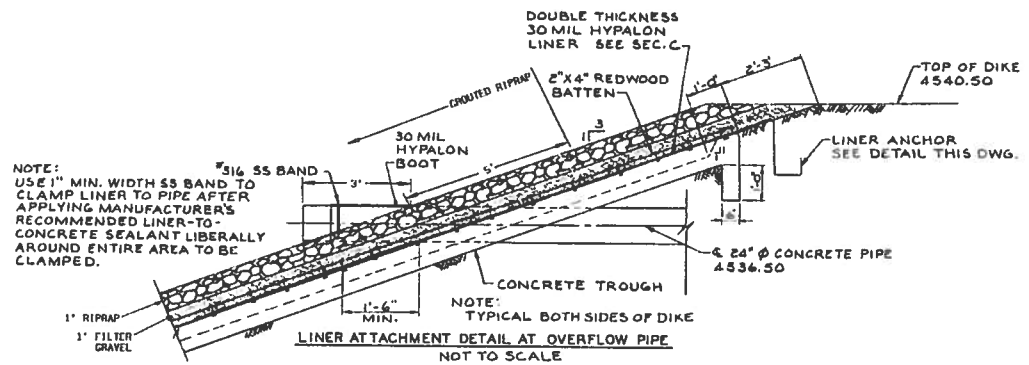


NOTE:
 USE 1" MIN. WIDTH SS BAND TO CLAMP LINER TO PIPE AFTER APPLYING MANUFACTURER'S RECOMMENDED LINER-TO-CONCRETE SEALANT LIBERALLY AROUND ENTIRE AREA TO BE CLAMPED.


LINER ATTACHMENT DETAIL AT OVERFLOW PIPE
 NOT TO SCALE

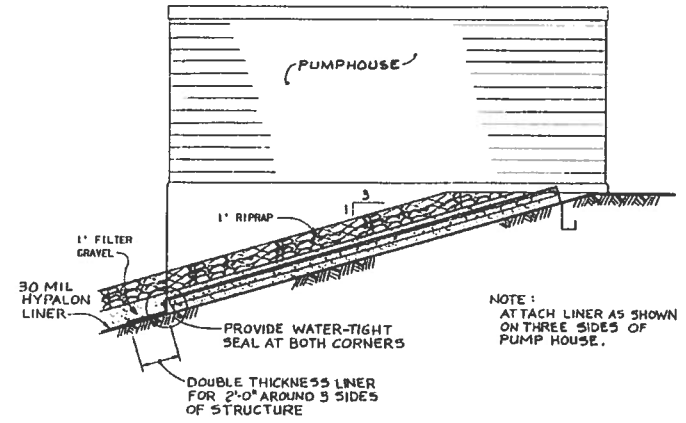


NORTH ELEVATION
 NOT TO SCALE

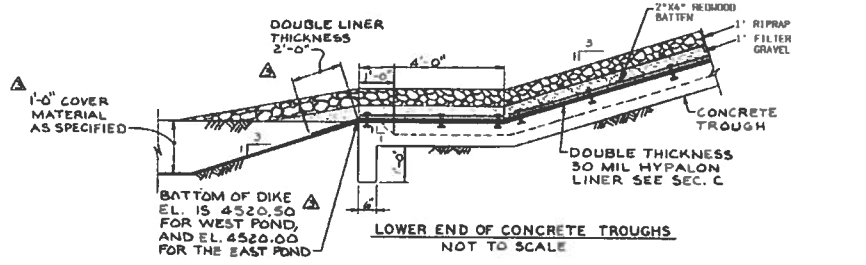

LOWER END OF CONCRETE TROUGHS
 NOT TO SCALE

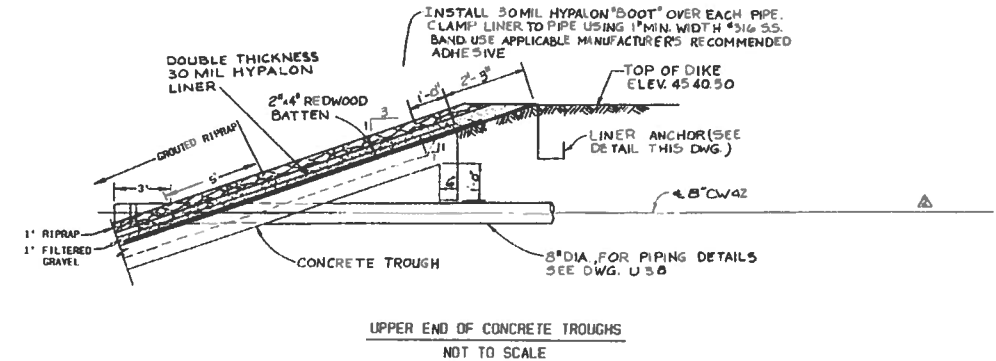


UPPER END OF CONCRETE TROUGHS
 NOT TO SCALE

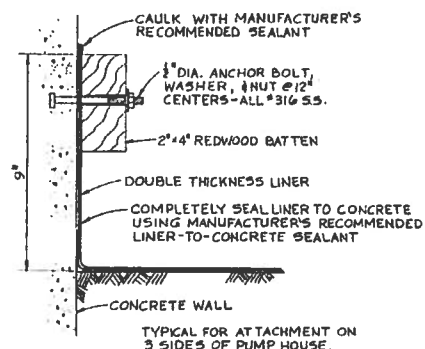

SECTION B
 NOT TO SCALE

DETAILS OF ATTACHMENT AND TERMINATION OF LINER AT PUMP HOUSE

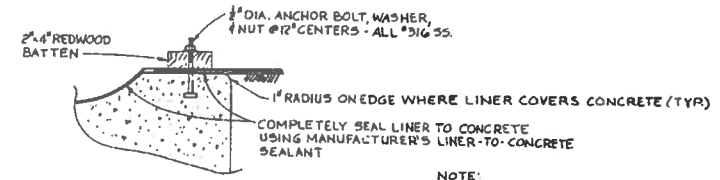

DETAIL 1
 NOT TO SCALE

TYPICAL DETAILS OF LINER ATTACHMENT AT CONCRETE TROUGHS

NOTE:
 THERE IS ONE THREE-PIPE INLET CONCRETE TROUGH, ONE ONE-PIPE INLET CONCRETE TROUGH, AND TWO OVERFLOW PIPE CONCRETE TROUGHS.

NO.	DATE	BY	REVISION
1	5/15/78	EWS	THIS DWG. ADDED AS PER CHANGE ORDER NO. 3001
2	5/19/78	DEH	ISSUED
3	6-6-78	PJM	ADDED COORDINATE AND 8" CW42 THROUGH DETAIL REVISION
4	6-9-78	DEH	ISSUED
5	6-14-78	DJB	REVISED AMOUNT OF COVER MATERIAL, AND EL. OF BOTTOM OF DIKE IN THE EAST POND AS PER CHANGE ORDER NO. 3449-13
6		DEH	ISSUED
7	12/1/80	FOBA	CONFORMING TO CONSTRUCTION RECORDS
8	1/15/78	RIT	AS BUILT TO SHOW FILTER GRAVEL AND RIPRAP

EMERGENCY HOLDING POND DETAILS
 CONTRACT NO. 3449
 YARD STRUCTURES


LARAMIE RIVER STATION
 UNITS 1&2
 Wheatland, Wyoming

MISSOURI BASIN POWER PROJECT

Burns & McDonnell
 Engineers - Architects - Consultants
 ST. LOUIS, MISSOURI





DESIGNED BY: EWS
 CHECKED BY: EWS
 DATE: Y172-5
 APP. REA. PROJECT: 74-0121
 APP. PROJ. MGR. SHEET: 1 OF 1 SHEETS

Y172

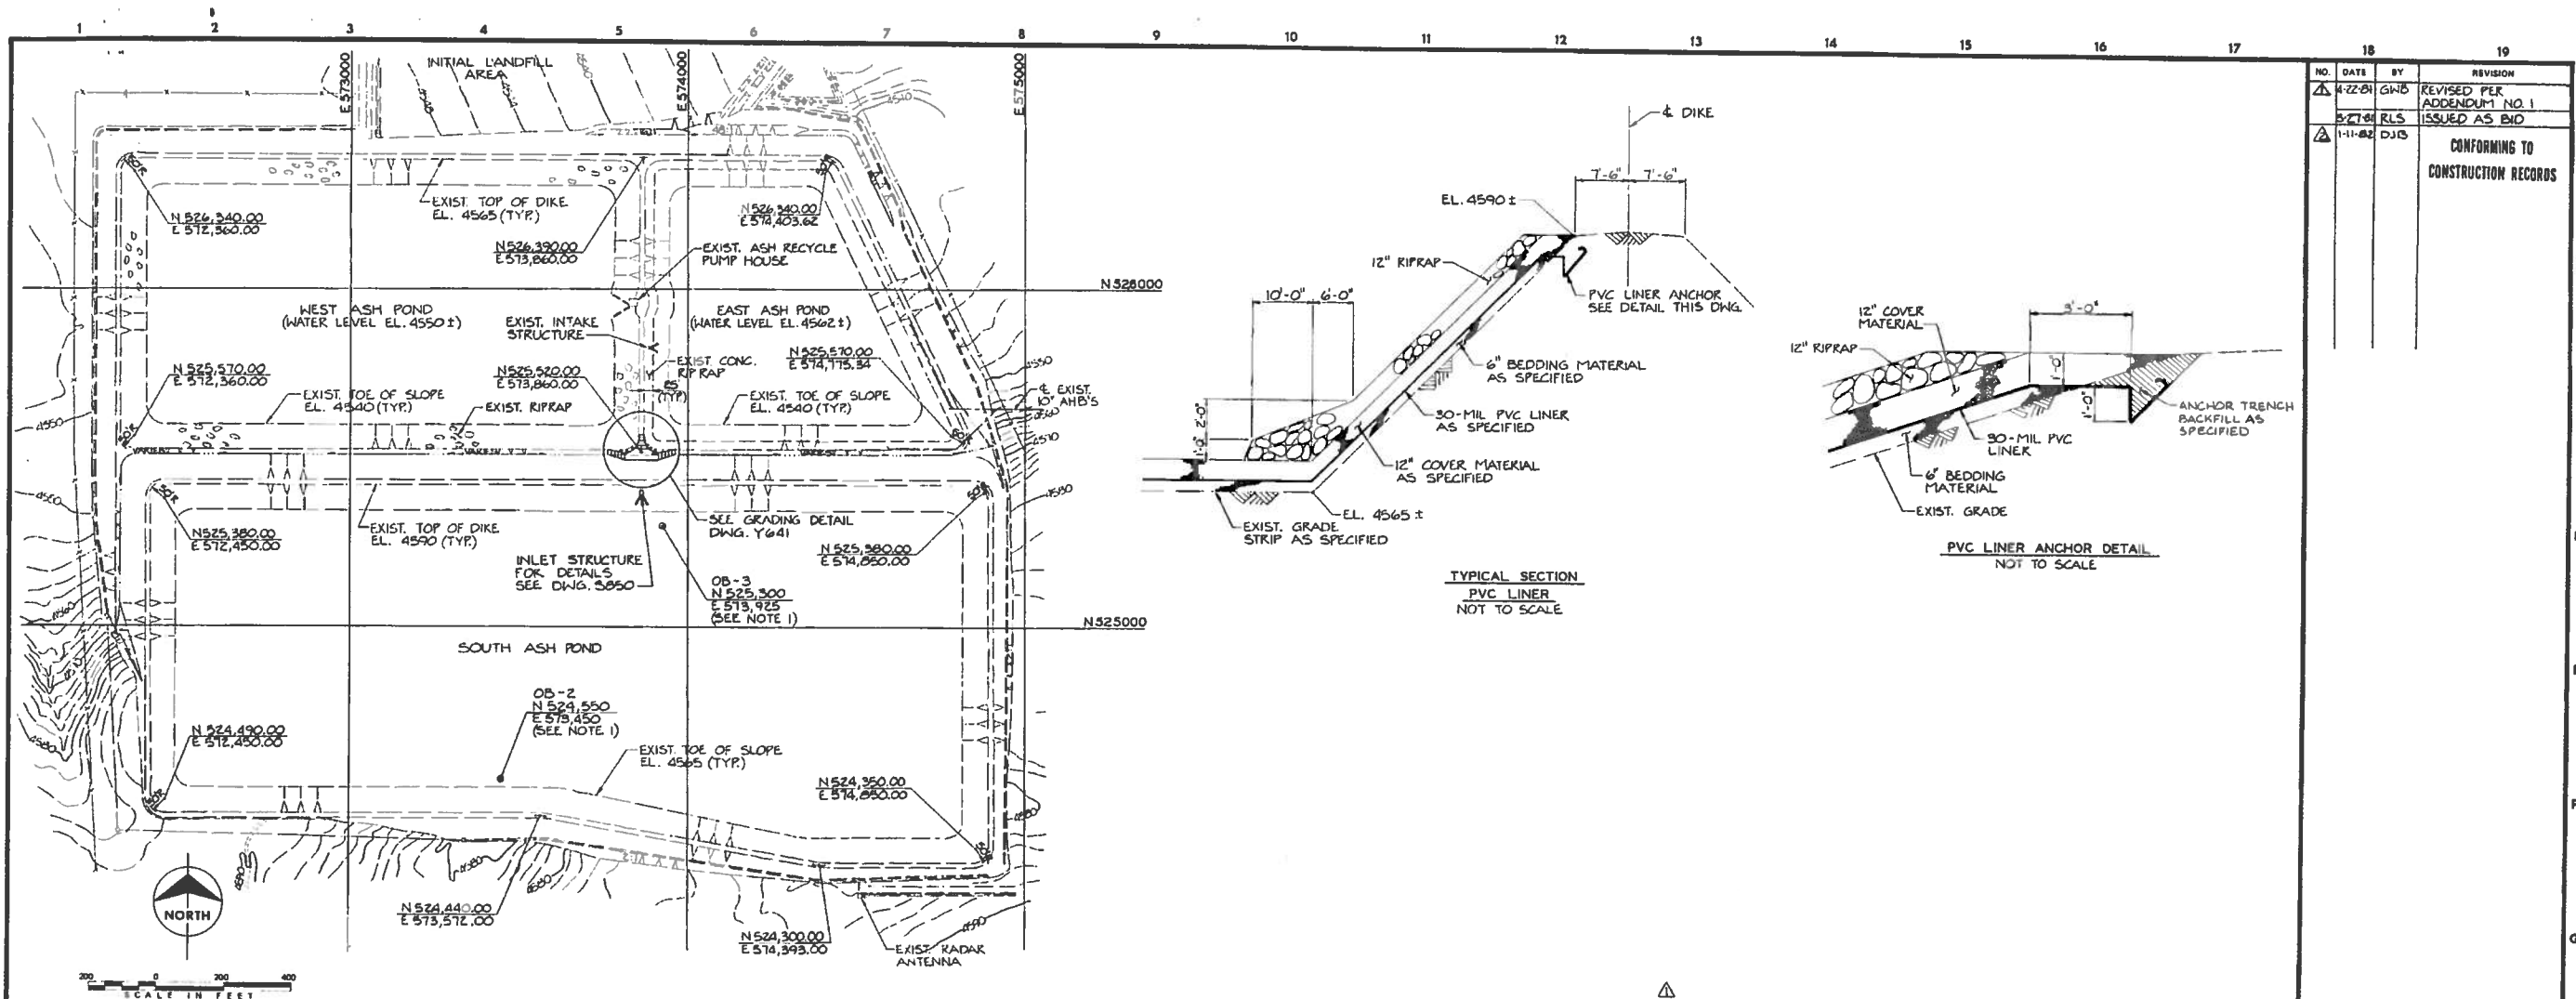

PLAN

- NOTES:
- OB-2 AND OB-3 ARE EXIST. PIEZOMETERS CONSTRUCTED OF 2" PVC PIPE. CUT OFF AND CAP PVC PIPE 1'-0" BELOW LINER.
 - ALL SIDE SLOPES ARE 3:1, UNLESS OTHERWISE NOTED.

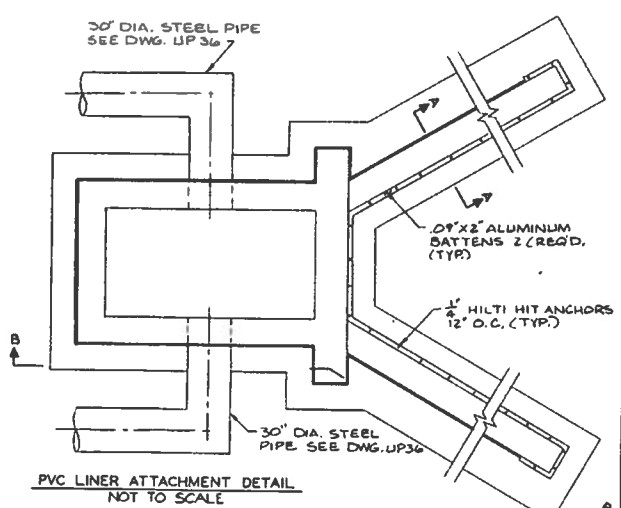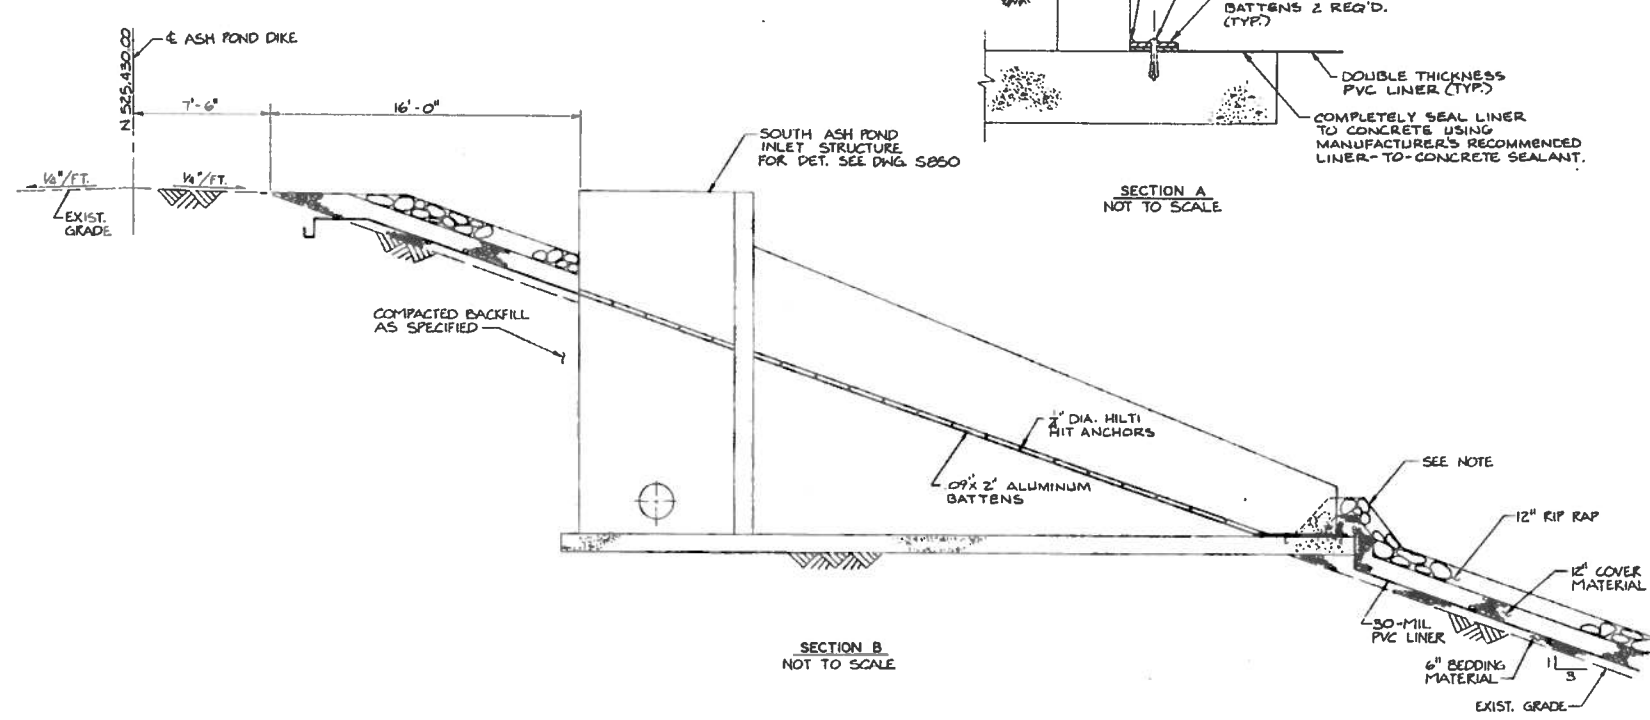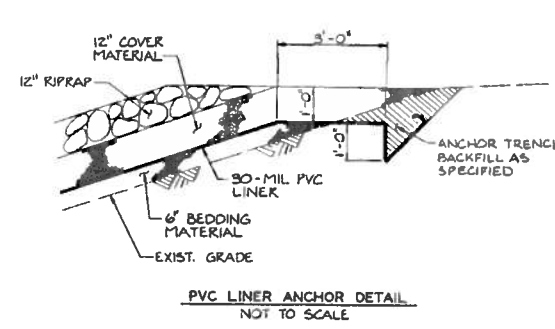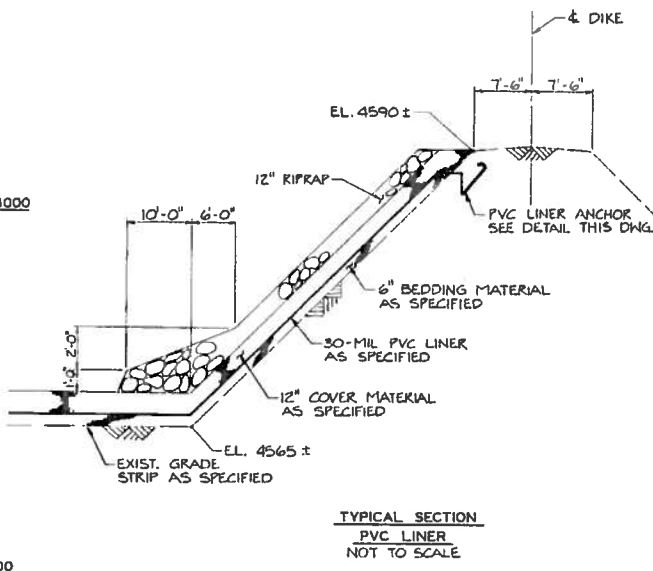


NOTE:
PVC LINER SHALL BE COVERED BY A MINIMUM OF 12" COVER MATERIAL AND 12" RIPRAP WHERE PVC LINER ATTACHES TO INLET STRUCTURE.

NO.	DATE	BY	REVISION
1	4-22-81	GWB	REVISED PER ADDENDUM NO. 1
2	5-27-81	RLS	ISSUED AS BID
3	1-11-82	DJS	CONFORMING TO CONSTRUCTION RECORDS

SOUTH ASH POND DETAILS CONTRACT NO. 3333 SOUTH ASH POND LINER	
LARAMIE RIVER STATION UNIT 3 Wheatland, Wyoming MISSOURI BASIN POWER PROJECT	
Burns & McDonnell Engineers - Architects - Consultants KANSAS CITY, MISSOURI	
DATE: APRIL 17, 1981	DRAWING NO. Y640 - 2
APP. REA	PROJECT 77-111-1
APP. PROJ. MGR.	SHEET OF SHEETS

Y640

Appendix III

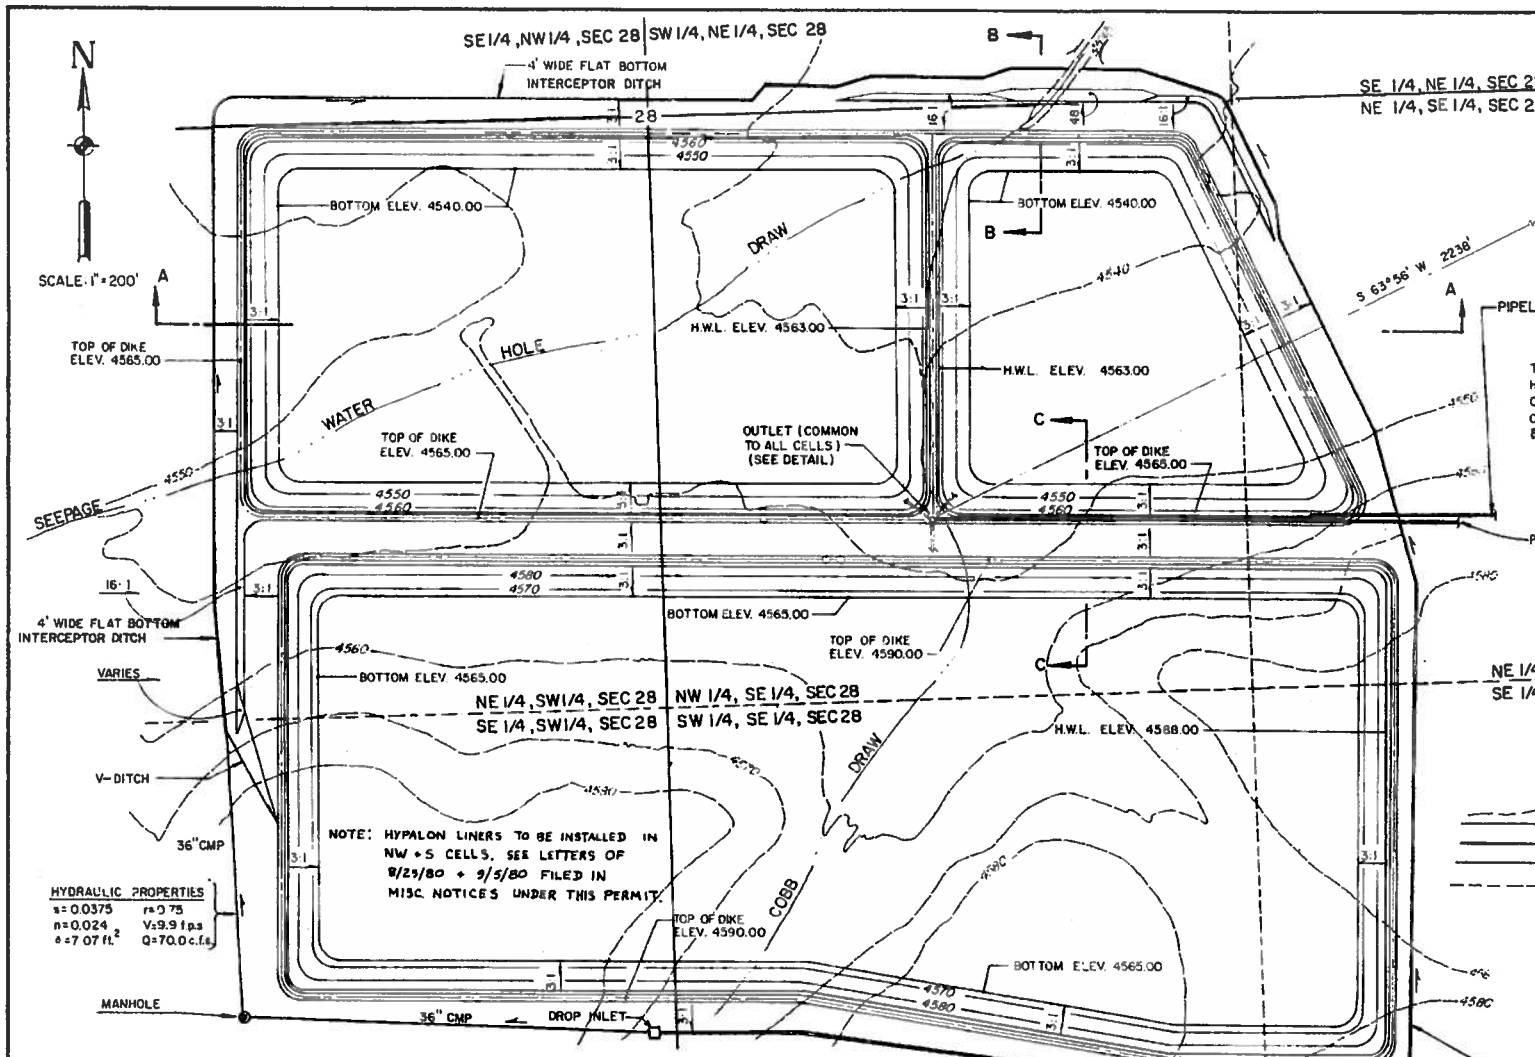

SE 1/4, NE 1/4, SEC 28
NE 1/4, SE 1/4, SEC 28


E 1/4 CORNER SECTION 28
T 25N, R 67W

PIPELINE FROM PUMP AT POWER PLANT
PUMP DATA
TYPE CONSTANT SPEED CENTRIFUGAL
HORSEPOWER: 250
OUTPUT CAPACITY: 2100 GPM (4.67 cfs.)
OUTPUT HEAD: 280 FEET
EFFICIENCY: 89 %

PIPELINE TO POWER PLANT

NE 1/4, SE 1/4 SEC 28
SE 1/4, SE 1/4 SEC 28

LEGEND
--- EXISTING CONTOURS
--- NEW CONTOURS
--- PIPELINES
--- 1/4 SECTION LINE
--- 1/8 SECTION LINE

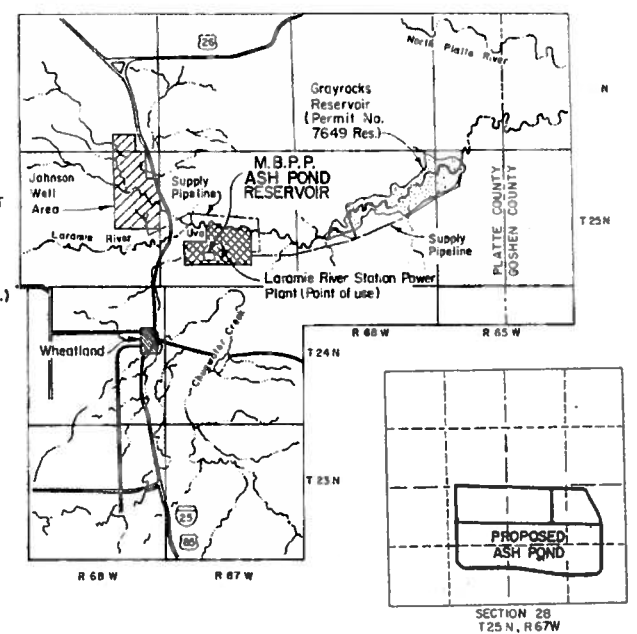


LOCATION MAPS
NO SCALE

CERTIFICATION


I, Joseph C. Lord, of Laramie, Wyoming, hereby certify that this map has been prepared under my direct on and that it correctly represents the proposed ash pond to accompany the application filed herewith. Engineering design shown hereon was developed by Burns & McDonnell, of Kansas City, Missouri Section corners, and subdivision lines were established by Banner Associates, Inc., during an actual survey of the proposed Missouri Basin Power Project Laramie River Station Site, made during February, March, and April 1975.

Joseph C. Lord
Joseph C. Lord Wyoming PE No 190

M.B.P.P. ASH POND RESERVOIR
TOTAL AREA = 104.6 ACRES
TOTAL CAPACITY = 2111.1 ACRE-FEET

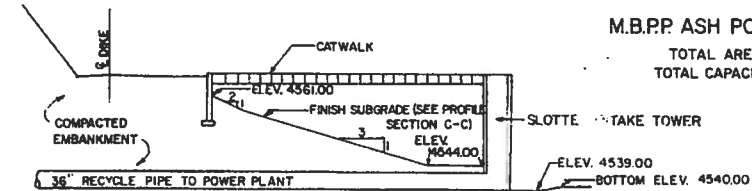


OUTLET WORKS DETAIL
NO SCALE

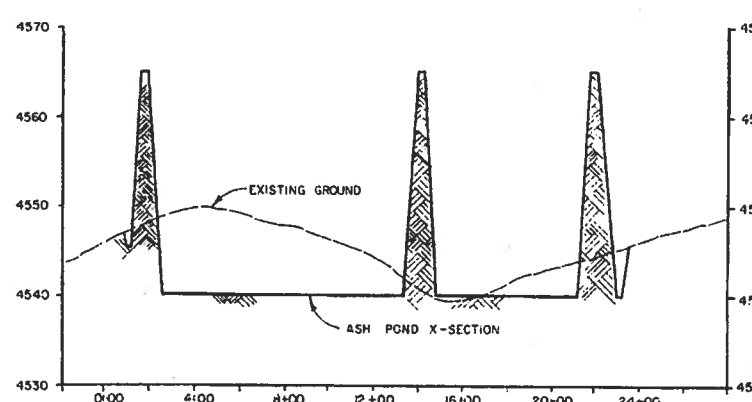

SECTION A-A
SCALE: HORIZ. 1" = 40'
VERT. 1" = 10'

APPROVED: *George L. Christophulos*
GEORGE L. CHRISTOPULOS, STATE ENGINEER

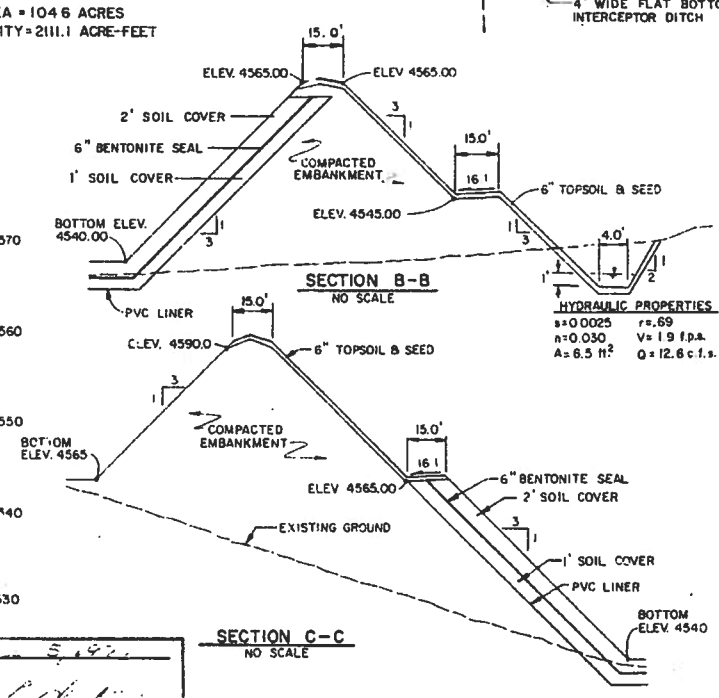

SECTION C-C
NO SCALE


STORAGE RESERVOIR CAPACITY TABLE				
ELEVATION	AREA (acres)	AVERAGE END AREA (acres)	CAPACITY (acre-feet)	ACCUMULATED CAPACITY (acre-feet)
NORTHEAST CELL				
BOTTOM 4540	10.0			
4545	10.8	10.4	52.0	52.0
4550	12.0	11.4	57.0	109.0
4555	12.9	12.3	62.3	171.3
4560	14.1	13.5	67.5	238.8
MAX. H.W.L. 4563	15.1	14.6	43.8	282.6
NORTHWEST CELL				
BOTTOM 4540	22.8			
4545	24.1	23.5	117.3	7.3
4550	25.7	24.9	124.5	241.8
4555	27.1	26.4	132.0	373.8
4560	28.8	28.0	139.8	513.6
MAX. H.W.L. 4563	30.2	29.5	89.5	602.0
SOUTH CELL				
BOTTOM 4565	48.0			
4570	30.1	49.1	245.3	245.3
4575	32.5	51.3	256.5	301.8
4580	35.0	53.8	268.8	770.3
4585	37.4	56.2	281.0	1051.3
MAX. H.W.L. 4588	39.3	58.4	173.1	1226.6
TOTAL CAPACITY			2111.1 Acre-Feet	

TOTAL STORAGE (ACTIVE)
POLLUTION CONTROL
211.1 ACRE-FEET


MAP
TO ACCOMPANY APPLICATION FOR
M.B.P.P. ASH POND RESERVOIR
OCY-6004
APPLICANT
BASIN ELECTRIC POWER COOPERATIVE
1717 EAST INTERSTATE AVE
BISMARCK, NORTH DAKOTA 58501

781000 22 '22


OCY-6004

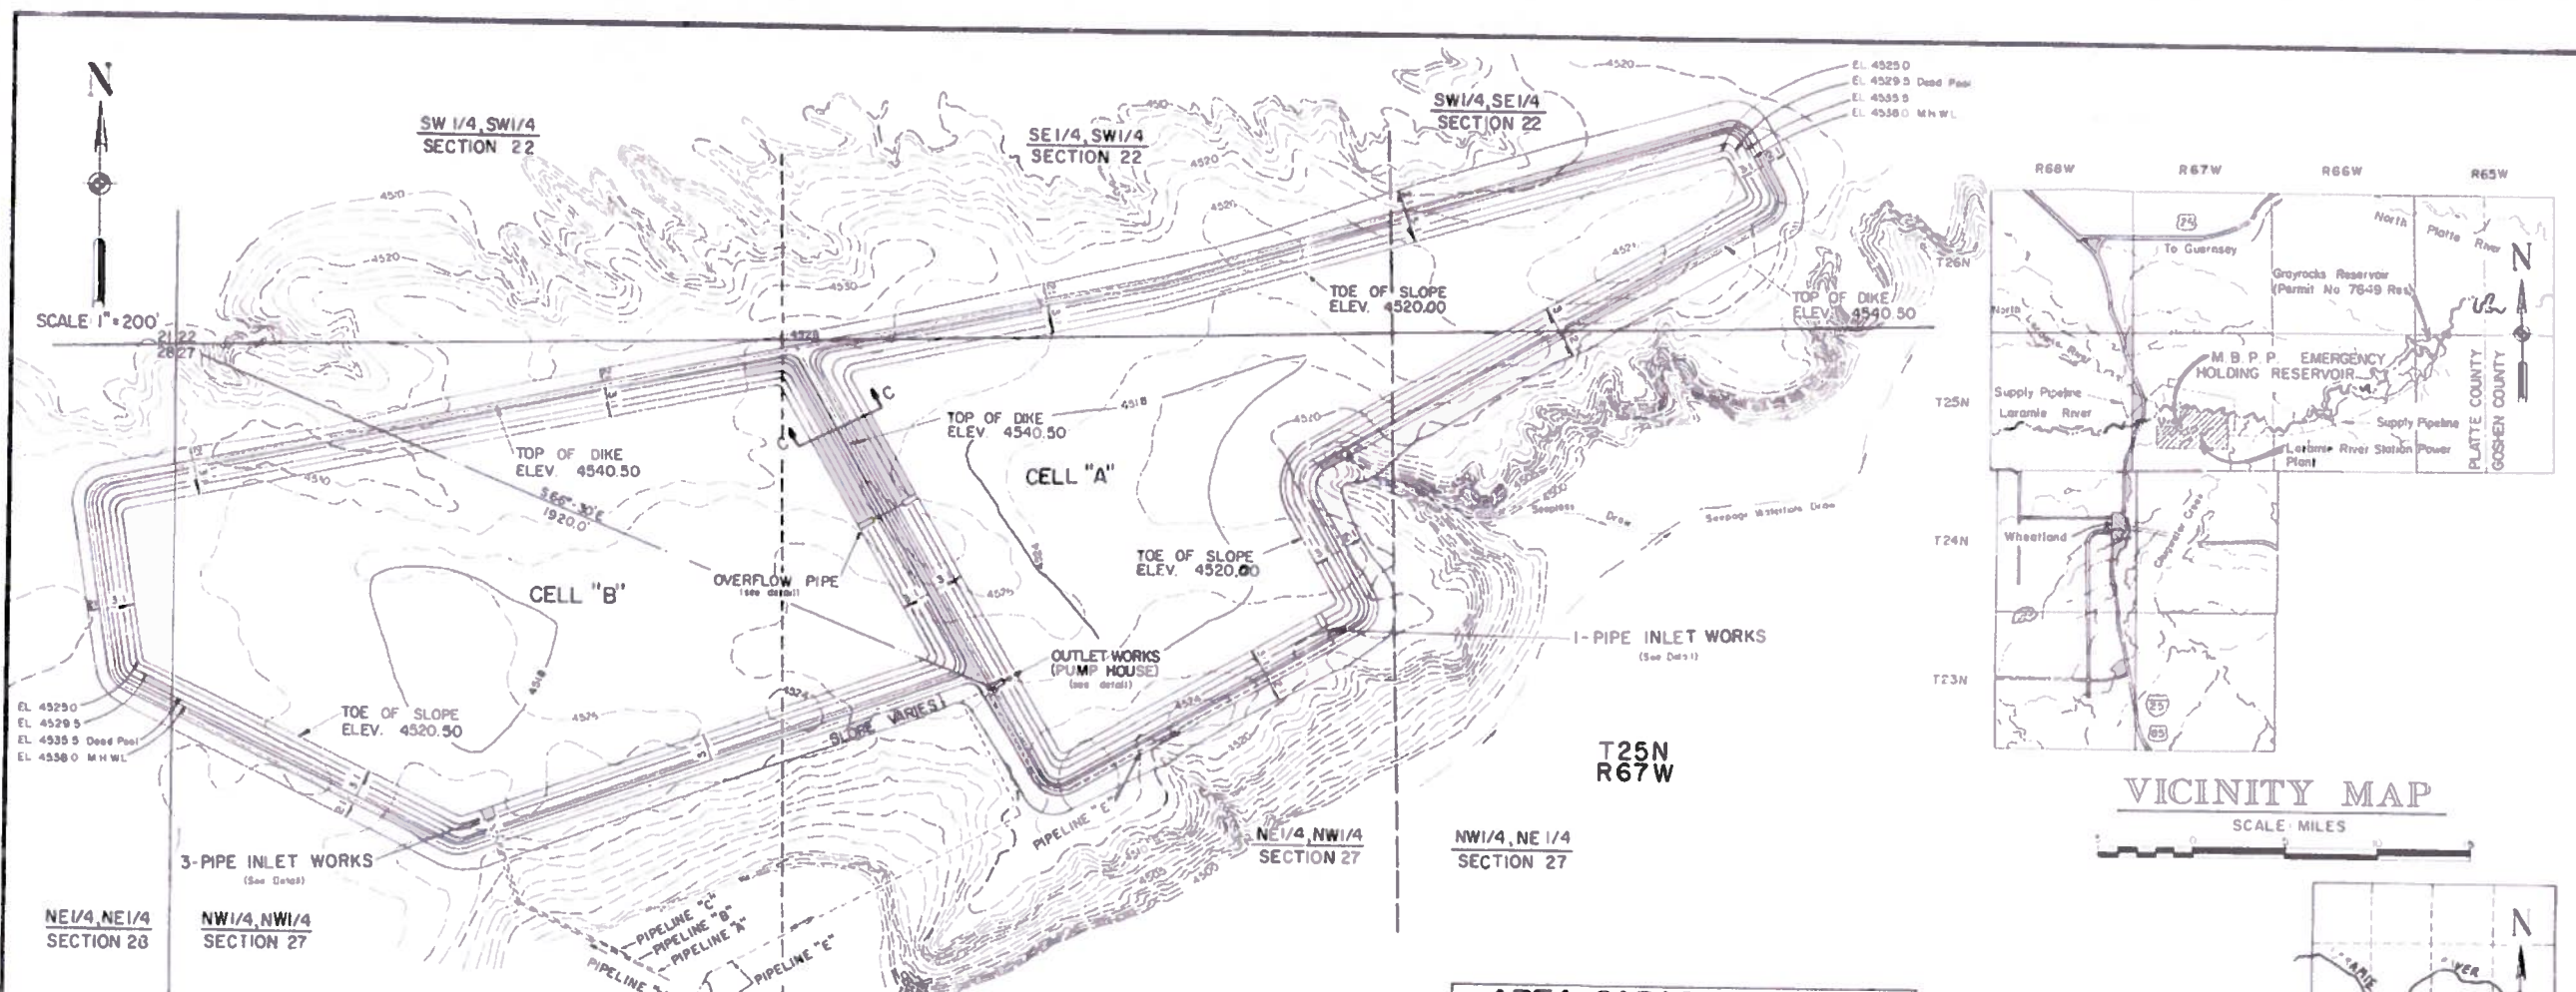

**PLAN
MBPP EMERGENCY HOLDING RESERVOIR**
 TOTAL AREA = 54.10 ACRES
 TOTAL CAPACITY = 915.70 ACRE-FEET

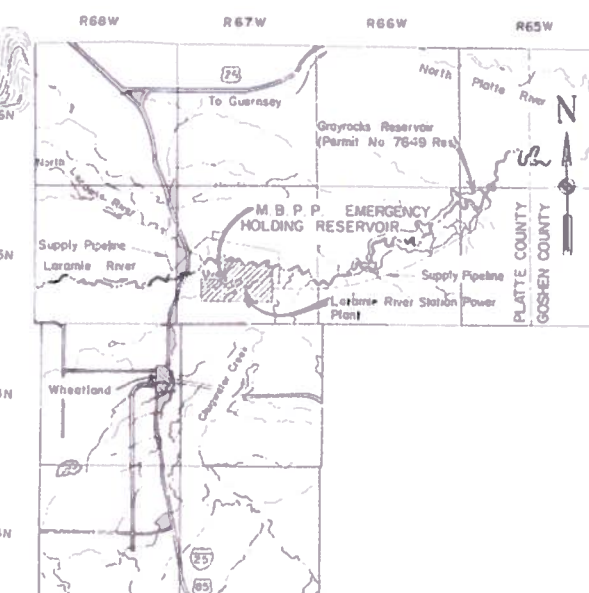

VICINITY MAP
SCALE: MILES

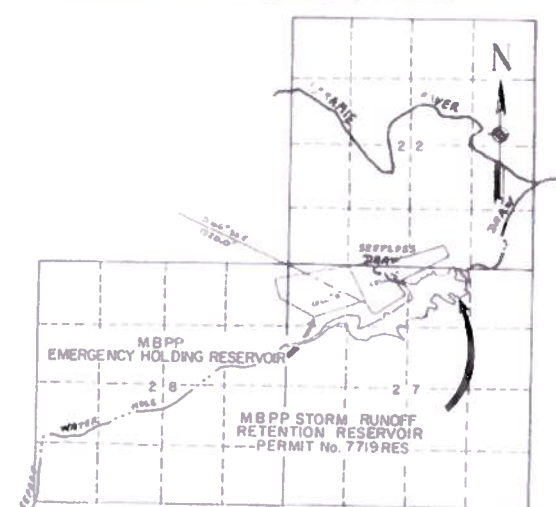

LOCATION MAP
SCALE 1" = 200'

CERTIFICATION

I, Joseph C. Lord, of Laramie, Wyoming, hereby certify that this map has been prepared under my direction and that it correctly represents the proposed emergency holding reservoir to accompany the application filed herewith. Engineering design shown hereon was developed by Burns & McDonnell, of Kansas City, Missouri. Section lines, corners, and subdivision lines were established by Banner Associates, Inc., during an actual survey of the proposed Missouri Basin Power Project Laramie River Station Site, made during February, March, and April 1975.

Joseph C. Lord
Joseph C. Lord Wyoming P.E. No 1903

LEGEND

	EXISTING CONTOURS
	NEW CONTOURS
	PIPELINE
	SECTION LINE
	1/4 SECTION LINE
	1/16 SECTION LINE

* After submitting the original filing for the MBPP Emergency Holding Reservoir, T.F. No 23 2/149, a change in design increased the capacity by 7.3 acre-feet. A new application was filed and this original map was revised. Therefore, this map will serve both the rejected filing and the new filing. See letter dated May 21, 1979, filed with Rejected Application, T.F. No 23 2/149.

AREA-CAPACITY TABLE

ELEVATION	SURFACE AREA (ACRES)	AVERAGE END AREA (ACRES)	Δ CAPACITY (ACRE-FEET)	Σ CAPACITY (ACRE-FEET)
4518.5	0	0	0	0
4518.0	7.3	2.4	6.0	6.0
4520.0	19.1	13.2	26.4	32.4
4525.0	20.9	20.0	100.0	132.4
4526.5	22.6	21.8	98.1	230.5
4535.5	24.7	23.8	141.6	372.1
4538.0	25.7	26.2	63.0	435.1
4518.0	0	0	0	435.1
4518.0	1.4	0.5	1.0	1.0
4520.5	23.1	12.3	30.7	31.7
4525.0	24.4	23.7	106.7	138.4
4529.5	25.8	25.1	112.9	251.3
4535.5	27.5	26.6	109.6	410.9
4538.0	28.4	27.9	69.7	480.6
TOTAL CAPACITY			915.70	915.70

PIPELINE (INLET) DATA

PIPE	DIAMETER (in)	MATERIAL	Q (gpm)	SOURCE
A	6	PVC	500	UNIT 1 DEMINERALIZER
B	8	FRP	800	DEMINERALIZER BUILDING (SCRUBBER SLUDGE)
C	6	PVC	400	WATER TREATMENT PLANT (ACID WASTE)
D	6	FRP	485	ASH POND (BLOW DOWN)
E	8	FRP	987	CIRCULATING WATER SYSTEM (COOLING TOWERS)

Temp. File No 23 2/149 REJECTED: April 21, 1980	Temp. File No 23 2/181 APPROVED: April 21, 1980
<i>George L. Christophulos</i> GEORGE L. CHRISTOPULOS, STATE ENGINEER	<i>George L. Christophulos</i> GEORGE L. CHRISTOPULOS, STATE ENGINEER

MAP TO ACCOMPANY APPLICATION FOR MBPP EMERGENCY HOLDING RESERVOIR

APPLICANT
BASIN ELECTRIC POWER COOPERATIVE
1717 E. INTERSTATE AVE.
BISMARCK, NORTH DAKOTA 58501

FACILITY: LARAMIE RIVER STATION
LOCATION/UNIT: 1 2 3
BASIN NUMBER: 0CY-6005

MAR, 1979 SHT. 1 OF 2

13 21 77 22 P.L. 0-19 Rejected 8120 P.C.